LAND CORNER RECORDATION CERTIFICATE

Filing Requirement of Act 74, Mich. P.A. 1970 as Amended

For corners in

Baraga (County) Located In: Corner Code #

1. Public Land Survey		T 48N	R 31W	I5
		T	R	
		T	R	
2. Property Controlling	S	T	R	
in Section	S 14	T 48N	R 31W	4
	S	T	R	
3. Miscellaneous	S	T	R	
Property in Sec.	S	T	R	

4. Lot No. _____, Recorded Plat _____

5. Private Claims

Register of Deeds Stamp & File Number

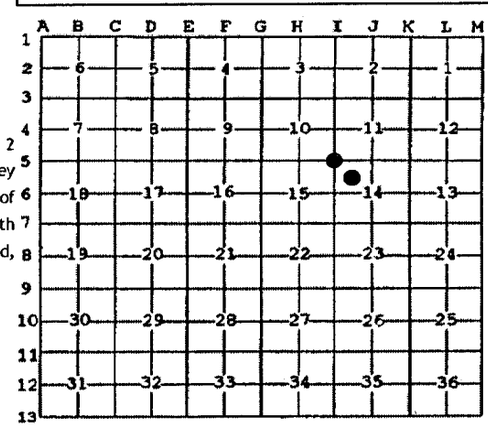

I, Stephan J. Szyszkoski, in a field survey on I5 04/28/2010 4 04/28/2010 do hereby state that under requirements of P.A. 74, Michigan P.A. of 1970, the corner points mentioned in lines 1 and 2 above were in conformance with regulations and rules therefore as required in the current manual of survey instructions of the United States Department of the Interior, Bureau of Land Management or by a decree of a Court of Law and /or that the corner points mentioned in lines 3, 4 and 5 above were in conformance with the rules of the Michigan Board of Land Surveyors or by a Decree of a Court of Law; established, re-established, monumented, recovered, found as expressed below:

NOTE: Not more than 2 corners, all in the same town and range, may be recorded on this certificate.

A. Description of original monument and accessories and/or subsequent restoration:

(I5) Corner common to Sections 10-11-14-15. 1848 - Established by Wells Burt Deputy Surveyor. Set spruce post. Spruce 8 N61W 27 links, Spruce 7 S40E 46 links. 1957 - Dean C. DeLaMater RLS searched for the original corner in 1957 on behalf of the Michigan Dept. of Conservation. He found a squared post by others but no original evidence.

(4-Sec. 14) Northwest 1/16 corner, Section 14. Not established in the original survey.

B. Description of corner evidence found and/or method applied in restoring or reestablishing corner:

(I5) The original post and accessories were not recovered. Found 3 rotted post points, and a newer wooden post, all adjacent - all apparently the perpetuation of an approximate corner position. From the position of the post, the record position by double proportionate measurement between corners 1 mi. west, north, east, and 1/2 mi. south is S62E 56.5'. I conclude that the post's position is not a perpetuation of the original corner position, is not supported by the original record, and I do not accept it as perpetuating the position of the original corner. I reestablished the corner at the proportionate position, noted above, between corners 5279.43' West, 5207.44' North, 5279.35' East, and 2604.02' South. I note that it is common in this township to find the N-S distances between corners to be substantially short of the GLO record.

(4-Sec. 14) Established the corner at the intersection of straight lines connecting opposite 1/16 corners.

C. Description of monument for corner and accessories established to perpetuate locating the position of the corner:

(I5) Set 1"IDx32" I.pipe with 4" alum. MDNR cap.
Set measuring nail with MDNR tag in the side of:
6" Tamarack N67E 6.65' mrkd "S11 NBT"
7" B.Spruce S14E 24.05' "S14 NBT"
4" Tamarack S66W 4.65' "S15 NBT"
7" Tamarack N30W 20.8' "S10 NBT"
Set sq'd Tam. post adjacent.
Bearings are magnetic.

(4) Set 1"IDx32" I.pipe with 4" alum. MDNR cap.
Set measuring nail with MDNR tag in the side of:
6" B.Spruce N42E 17.3' mrkd "1/16S BT"
5" Hemlock S86E 31.9' do
3" Sugar S11E 14.75' do
4" Balsam S60W 22.05' do
Bearings are magnetic.

Signed by Stephan J. Szyszkoski Date 07/07/2010

Surveyor's Michigan License No. 33986

STATE OF MICHIGAN STEPHAN J. SZYSZKOSKI LAND SURVEYOR No. 33986 LICENSED LAND SURVEYOR

For the Michigan Department of Natural Resources and Environment, Forest Management Division

16436

16437

FORM APPROVED BY MICHIGAN STATE BOARD OF REGISTRATION FOR PROFESSIONAL SURVEYORS, Nov. 16, 1971
Revised May 14, 1975
Revised Jan., 1983
Revised Oct., 1995