

# LAND CORNER RECORDATION CERTIFICATE

## FILING REQUIREMENT OF ACT 74, MICH. P.A.1970

FOR CORNERS OF--:	LOCATED IN--:	CORNER CODE NUMBER
1. PUBLIC LAND SURVEY _____	T. 48 N. <del>S.</del> R. 32 <del>W.</del>	F5, G1, H3, B3
2. PROPERTY CONTROLLING IN SECTION 9 _____	T. 48 N. <del>S.</del> R. 32 <del>W.</del>	15
3. MISCELLANEOUS PROPERTY IN SECTION _____	T. _____ N. <del>S.</del> R. _____ E. <del>W.</del>	
4. LOT NO. _____, RECORDED PLAT _____		
5. PRIVATE CLAIMS _____		

REGISTER OF DEEDS STAMP AND FILING NUMBER

I, Keith L. Sackett do hereby certify that under requirements of P.A. 74, Michigan P.A. of 1970, the corner points mentioned in lines 1 and 2 above (identified with circles on index code diagram - over) were, in a field survey on see below 19\_\_\_\_, established, re-established, monumented, re-monumented, recovered or restored as expressed below and in conformance with regulations and rules therefore as required in the current manual of survey instructions of the United States Department of the Interior, Bureau of Land Management or by a decree of a court of law. Furthermore, that the corner points mentioned in lines 3, 4 and 5 above were, in a field survey on \_\_\_\_\_ 19\_\_\_\_, found, recovered, restored, established or re-established as expressed below and in conformance with the rules of the Michigan State Board of Registration for Land Surveyors or, by a Decree of a Court of law:

**A. Description of original monument and accessories and/or subsequent restoration:**

- Corner F5: Original monument and accessories not found.
- Corner 15: Not set on original survey nor subsequently apparently.
- Corner G1: Original monument and accessories not found. We found 8" spruce N47°E (Mag.) 9.8 ft. marked BT. Location poster from Northern Paper Mills. We also found scribed post.
- Corner H3: Original monument and accessories not found.
- Corner B3: Original monument and accessories not found. Found scribed post. Blazed lines N-S, E-W.

**B. Description of corner evidence found and/or method applied in restoring or re-establishing corner:**

- Corner F5: Re-established 9-2-75 on line between section corners east and west.
- Corner 15: Established 9-2-75 on line between section corner west and 1/4 corner east.
- Corner G1: Re-established 7-2-75 at scribed post. It is good with other corners in the area.
- Corner H3: Re-established 7-2-75 on line between section corners east and west.
- Corner B3: Re-established 6-30-75 at scribed post.

**C. Description of monument for corner and accessories established to perpetuate locating the position of the corner:**

- |   |   |
|---|---|
| <p><u>Corner F5</u>: Set 1" I.D. x 36" iron pipe with 4" aluminum cap<br/>                 14" Sugar S82°E (Mag.) 27.3 ft. 1/4S, NBT<br/>                 18" Y. Birch N02°E (Mag.) 21.1 ft. 1/4S, NBT<br/>                 *Marker tree S69°W (Mag.) 3.9 ft. marked 1/4, 9, 16 *14" spruce</p> <p><u>Corner 15</u>: Set 1" I.D. x 36" iron pipe with 4" aluminum cap<br/>                 7" Cherry S38°W (Mag.) 8.1 ft 1/16S, BT<br/>                 16" Elm N21°E (Mag.) 20.9 Ft 1/16S, BT</p> | <p><u>Corner G1</u>: Set 1" I.D. x 36" I.P. with 4" alum. cap.<br/>                 10" W. Birch N78°W (Mag.) 33.3 ft. S33, NBT<br/>                 6" Cedar S63°E (Mag.) 32.8 ft. S3, NBT</p> <p><u>Corner H3</u>: Set 1" I.D. x 36" I.P. with 4" alum. cap.<br/>                 5" Balsam N84°E (Mag.) 7.7 ft. 1/4S, NBT<br/>                 8" W. Birch S22°W (Mag.) 2.7 ft. 1/4S, NBT<br/>                 Squared 3" Balsam N28°W (Mag.) 1.6 ft.</p> <p><u>Corner B3</u>: Set 1" I.D. x 36" I.P. with 4" alum. cap.<br/>                 10" Sugar S54°E (Mag.) 15.7 ft. 1/4S, NBT<br/>                 8" Sugar S33°W (Mag.) 20.9 ft. 1/4S, NBT<br/>                 12" Sugar N14°E (Mag.) 10.5 ft. 1/4S, NBT</p> |
|---|---|


SIGNED BY \_\_\_\_\_ DATE \_\_\_\_\_

SURVEYOR'S MICHIGAN REGISTRATION NO. \_\_\_\_\_ (SEAL)

FOR STATE AND UNITED STATES AGENCIES:

SIGNED BY \_\_\_\_\_ DATE \_\_\_\_\_


APPROVED AND SIGNED BY Keith L. Sackett DATE December 31 1975  
CHIEF OF SURVEY PARTY  
MICHIGAN REGISTERED LAND SURVEYOR  
 Keith L. Sackett  
 Michigan Department of Natural Resources

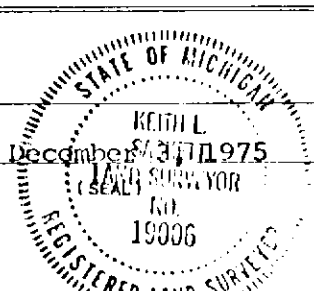

SURVEYOR'S MICHIGAN REGISTRATION NO. 19006


**CORNER NUMBERING CODE DIAGRAMS FOR IDENTIFYING LAND CORNER RECORDATIONS AND INDEXING**

**FOR PUBLIC LAND SURVEY CORNERS IN THE**  
**T. 48N , R. 32W (MENTIONED OVER)**

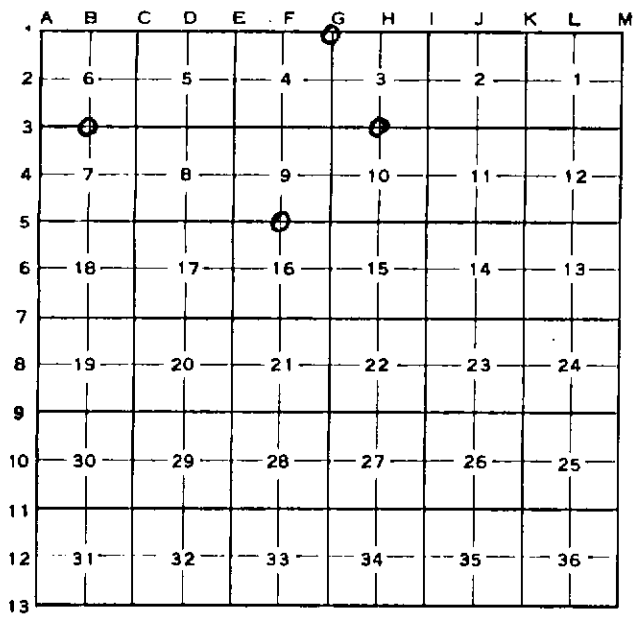

Apply letter prefix for corner points encircled above for identifying corner recordation numbers over.

**FOR PROPERTY CONTROLLING AND MISC. PROPERTY CORNERS WITHIN THE SECTION (MENTIONED OVER AND EXCLUDE LOT CORNER)**

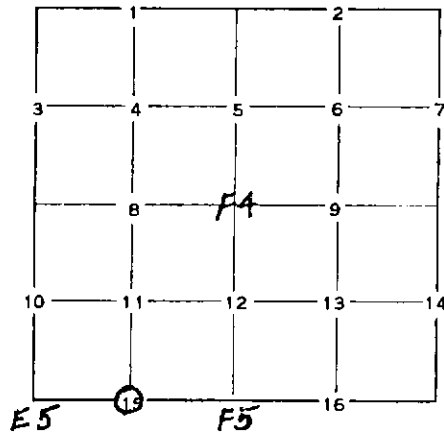

1. Above coded numbers are positioned on 1/16 fractional lines of the section.
2. Township corner code numbers shall be applied to corners of above typical section not numbered.
3. Miscellaneous property corners within a section, located at points other than numbered above, shall be referenced to at least two of above corner code numbers.
4. Private claim corners to be tied to rectangular land corners if possible - sketch required below.

**EXPLANATORY SKETCH IF NECESSARY -- BELOW**

