
LAND CORNER RECORDATION CERTIFICATE

FILING REQUIREMENT OF ACT 74, MICH. P.A.1970

FOR CORNERS OF-	: LOCATED	iN —:	CORNER CODE NUMBER	
1. PUBLIC LAND S	URVEY T. 48_ \$	V. E¥ R. <u>32.</u> ₩	A4 & A5	
2. PROPERTY CON	TROLL-	N. E. W.		
3. MISCELLANEOU PROPERTY IN S	S ECTION, T	S., R E.		
4. LOT NO	, RECORDED PLAT.		 	•
5. PRIVATE CLAIM	S			REGISTER OF DEEDS STAMP AND FILING NUMBER
the corner points field survey on— restored as expres of survey instruct court of law.	mentioned in lines 1 and December 7 1973 ssed below and in conform ions of the United States Furthermore, that the co 19, found, recove	2 above (identible), established, ance with regula Department of the rner points menued, restored, est	re-established, monumento tions and rules therefore a e Interior, Bureau of Land tioned in lines 3,4 and 5 tablished or re-established	P.A. 74, Michigan P.A. of 1970, code diagram — over) were, in a ed, re-monumented, recovered or s required in the current manual Management or by a decree of a above were, in a field survey on as expressed below and in contrs or, by a Decree of a Court of
A. Description of	original monument and ac	cessories and/o	r subsequent restoration:	
Corner A4:	Found no evidence monuments or acces	_	post or its accessor	ries or of any replacement
Corner A5:			post or its accessor o accessories visibl	ries. Found a 3"x3"x6' le.
Corner A4:	Re-established on Re-monumented corn but had obviously	line between er at the sc been there f	or many years. Posi	_
C. Description of	monument for corner and	accessories est	ablished to perpetuate loca	ating the position of the corner:
Corner A4:	1" I.D. x 36" iron Tamarack 12 S75°E Tamarack 13 N24°E	(mag.) 15.0	ft. "1/4S, NBT"	
Corner A5:	1" I.D. x 36" iron W. Pine 21 S81½°W W. Pine 18 S54°E	(mag.) 100.	8 ft. "S12, NBT"	
			D.4 M.F.	
	CHIGAN REGISTRATION			(con)
	UNITED STATES AGENC			(SEAL)
SIGNED BY			DATE	STATE OF CICHOLOGIA
APPROVED AND	МІСНІЄ	AN REGISTERED LAND	JAVEYOR DATE	OCTOBER 22, L1975
		Arthur O. Eng rtment of Nat	ger tural Resources	11581 115 SPARTIN
Form No. MLM735	HIGAN REGISTRATION N	FORM AF	PROVED BY MICHIGAN STATE BO	ARD OF REGISTRATION, JAN. 28, 1971
-	LAM 2 200, MICH.	DISTRIB	UTEO BY MICHIGAN SOCIETY OF	MEMORETERS CARD GORVEYORS


CORNER NUMBERING CODE DIAGRAMS FOR IDENTIFYING LAND CORNER RECORDATIONS AND INDEXING

FOR PUBLIC LAND SURVEY CORNERS IN THE T. 48N , R. 32W (MENTIONED OVER)

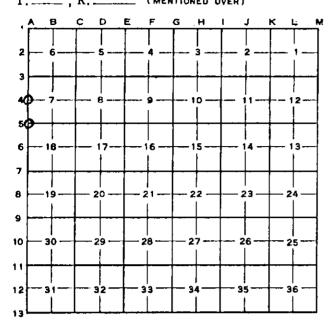

Apply letter prefix for corner points encircled above for identifying corner recordation numbers over.

FOR PROPERTY CONTROLLING AND MISC. PROPERTY CORNERS WITHIN THE SECTION (MENTIONED OVER AND EXCLUDE LOT CORNER)

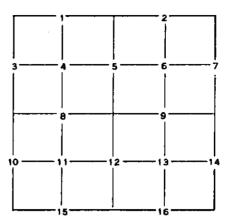

- 1. Above coded numbers are positioned on 1/16 fractional lines of the section.
- 2. Township corner code numbers shall be applied to corners of above typical section not numbered,
- 3. Miscellaneous property corners within a section, located at points other than numbered above, shall be referenced to at least two of above corner code numbers.
- 4. Private claim corners to be tied to rectangular land corners if possible sketch required below.

EXPLANATORY SKETCH IF NECESSARY -- BELOW

· ·
·
1
·