LAND CORNER RECORDATION CERTIFICATE
Filing Requirement of Act 74, Mich. P.A. 1970

For corners in Baraga (County)

	Located In:	Corner Code ##
1. Public Land Survey	T 48N R 32W	E9
	T ___ R ___	
	T ___ R ___	
	T ___ R ___	
2. Property Controlling in Section	S 20 T 48N R 32W	16
	S ___ T ___ R ___	
3. Miscellaneous Property in Sec.	S ___ T ___ R ___	
	S ___ T ___ R ___	

Register of Deeds Stamp & File Number

4. Lot No. _____ , Recorded Plat _____
5. Private Claims _____

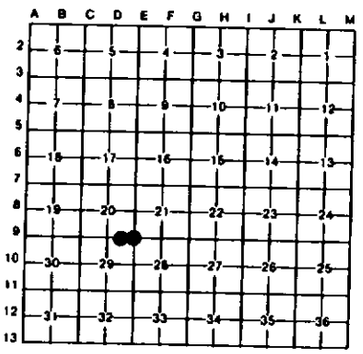

I, Stephan J. Szyszkoski, in a field survey on November 03, 1993, 19 _____, do hereby certify that under requirements of P.A. 74, Michigan P.A. of 1970, the corner points mentioned in lines 1 and 2 above were in conformance with regulations and rules therefore as required in the current manual of survey instructions of the United States Department of the Interior, Bureau of Land Management or by a decree of a Court of Law and/or that the corner points mentioned in lines 3, 4 and 5 above were in conformance with the rules of the Michigan Board of Land Surveyors or by a Decree of a Court of Law; established, re-established, monumented, re-monumented, recovered, found as expressed below:

NOTE: Not more than 4 corners, all in the same town and range, may be recorded on this certificate.

A. Description of original monument and accessories and/or subsequent restoration:

(E9) Section corner common to sections 20-21-28-29. Corner established in 1852 by Guy H. Carleton. Original post referenced by the following BTs: Cedar 10 N47E 34 links, Tamarack 12 S13W 25 links. The original record shows the following feature calls: 1) West, 4.00 ch. Enter highland NW, 2) South 3.88 ch. Leave swamp, 3) East 3.4 ch. Leave swamp N&S.

(16-Sec. 20) East 1/16 corner between Sections 20-29. Corner not established in the original survey. Found no subsequent record.

B. Description of corner evidence found and/or method applied in restoring or reestablishing corner:

(E9) Original post not recovered. Found an old squared cedar post, in tag alder marsh, with a Ford Motor Co. location poster affixed at very nearly record bearing and distance from the remains of an overturned cedar, very old. No scribing or markings were observed and it is difficult to determine exactly where the stump of the cedar had been prior to being thrown. No trace of the tamarack OBT was found. A Celotex Corp. poster dating 1966 is also affixed to the post and a Champion location poster on a dead white birch N05W 27.0' dated 1984 also faces the corner. Post location checks with the original record as referenced above: 1) checks, 2) checks, 3) 500+' meas. (Feature calls were observed to be inconsistent with the record in this portion of the township). Post location checks good with probable original corner location to the west and original corner location to the north. Accepted the old cedar as being a probable original BT and the post as the best available evidence of the position of the original corner. Monumented the post location with a 1" I.D.x72" iron pipe capped with a 4" dia. cast aluminum MDNR tablet.

(16-Sec. 20) Found no evidence of prior monumentation. Established the corner midway and on a straight line between 1/4 corner 1323.78' west and section corner 1323.78' east. At the position for the corner, I placed a 1"I.D.x32" iron pipe capped with a 4" dia. cast aluminum MDNR tablet.

C. Description of monument for corner and accessories established to perpetuate locating the position of the corner:

(E9) Set 1" pipe with 4" aluminum cap.
Blazed and scribed the following new bearing trees:
6" Maple N42E 30.8' "S21 NBT"
5" Balsam S56E 61.2' "S28 NBT"
5" Ash S05E 41.0' "S28 NBT"
Placed the old post adjacent.

(16) Set 1" pipe with 4" aluminum cap.
Blazed and scribed the following bearing trees:
6" Balsam N70W 16.6' "1/16S BT"
6" W. Birch S29W 5.1' "1/16S BT"
14" W. Pine S37E 66.2' "1/16S BT"
12" W. Pine N89E 48.9' "1/16S BT"
Set 3" Squared sugar post 1' north.
Centerline of N-S trail road East 19'
Found a post, assumed to be an approximate corner, North 53'.

STATE OF MICHIGAN
STEPHAN J. SZYSZKOSKI
LAND SURVEYOR
No. 33986
LICENSED LAND SURVEYOR

Signed by Stephan J. Szyszkoski Date 11-17-93

Surveyor's Michigan License No. 33986

FORM APPROVED BY MICHIGAN STATE BOARD OF LAND SURVEYORS, JAN. 28, 1971
REVISED MAY 14, 1975
REVISED JAN., 1983