

**LAND CORNER RECORDATION CERTIFICATE**  
**Filing Requirement of Act 74, Mich. P.A. 1970 as Amended**

For corners in

<u>Baraga</u> (County)	Located In:	Corner Code #
1. Public Land Survey	T48N R 32W	E10
	T48N R 32W	E11
	T ___ R ___	_____
2. Property Controlling in Section	S ___ T ___ R ___	_____
	S ___ T ___ R ___	_____
3. Miscellaneous Property in Sec.	S ___ T ___ R ___	_____
	S ___ T ___ R ___	_____
4. Lot No. _____, Recorded Plat _____		
5. Private Claims		

Register of Deeds Stamp & File  
Number

	A	B	C	D	E	F	G	H	I	J	K	L	M
1													
2	6		5		4		3		2		1		
3													
4	7		8		9		10		11		12		
5													
6	18		17		16		15		14		13		
7													
8	19		20		21		22		23		24		
9													
10	30		29		28		27		26		25		
11													
12	31		32		33		34		35		36		
13													

I, Stephan J. Szyszkoski, in a field survey on Oct 29, 2007 do hereby state that under requirements of P.A. 74, Michigan P.A. of 1970, the corner points mentioned in lines 1 and 2 above were in conformance with regulations and rules therefore as required in the current manual of survey instructions of the United States Department of the Interior, Bureau of Land Management or by a decree of a Court of Law and /or that the corner points mentioned in lines 3, 4 and 5 above were in conformance with the rules of the Michigan Board of Land Surveyors or by a Decree of a Court of Law; established, re-established, monumented, recovered, found as expressed below:

**NOTE: Not more than 2 corners, all in the same town and range, may be recorded on this certificate.**


A. Description of original monument and accessories and/or subsequent restoration:  
 (E10) Quarter corner common to Sections 28 and 29. 1852 - Established by Guy Carleton, Deputy Surveyor, midway and on the Section line between Section corners 39.94 chains north and south. Set post. Tamarack 6 S30W 30 links, Tamarack 4 N41E 39 links.

(E11) Corner common to Sections 28-29-32-33. 1852 - Established by Guy Carleton, Deputy Surveyor. Set post. Fir 8 S65E 25 links, Fir 10 N75W 20 links.

B. Description of corner evidence found and/or method applied in restoring or reestablishing corner:  
 (E10) The original post and accessories were not recovered. Found no acceptable evidence of the position of the original corner on the ground. Reestablished the corner midway and on the Section line between Section corners 2593.18' north and south. From the position thus established, I found a wood post, chainsaw-made by others, for a forester's approximate corner, 21' South and 5' West.

(E11) The original post and accessories were not recovered. Found no acceptable evidence of the position of the original corner on the ground. Reestablished the corner by double proportionate measurement to the original record between Section corner 10281.31' west, Section corner 5186.37' north, Quarter corner 13207.20' east, and Quarter corner 2594.11' south. From the position thus established, I found a wood post, a forester's approximate corner, S38W 62' distant.

C. Description of monument for corner and accessories established to perpetuate locating the position of the corner:  
 (E10) Set 1"IDx32" I.pipe with 4" alum. MDNR cap. Set measuring nail with MDNR tag in the side of:  
 6" B.Spruce N20E 11.15' mrkd "1/4S NBT"  
 4" B.Spruce N86E 13.2' do  
 3" B.Spruce S20W 11.5' do  
 4" B.Spruce N85W 8.45' do  
 Set sq'd cedar post adjacent. Bearings are magnetic.  
 (E11) Set 1"IDx32" I.pipe with 4" alum. MDNR cap. Set measuring nail with MDNR tag in the side of:  
 8" Maple N25E 20.2' mrkd "S28 NBT"  
 13" Maple N62E 19.0' do  
 9" Spruce S07E 2.2' "S33 NBT"  
 6" Spruce N78W 23.05' "S29 NBT"  
 Set sq'd cedar post adjacent. Bearings are magnetic.

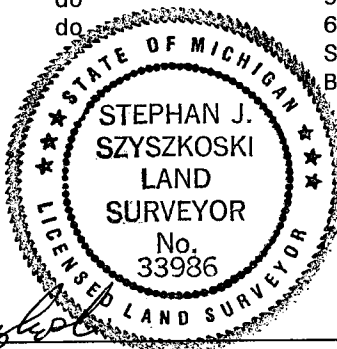

Signed by Stephan J. Szyszkoski Date 11/26/07

Surveyor's Michigan License No. 33986

For the Michigan Department of Natural Resources, Office of Land and Facilities

FORM APPROVED BY MICHIGAN STATE BOARD OF PROFESSIONAL SURVEYORS