

LAND CORNER RECORDATION CERTIFICATE
Filing Requirement of Act 74, Mich. P.A. 1970 as Amended

For corners in

Baraga	Located In:	Corner Code #
(County)		
1. Public Land Survey	T 48N R 32W	A4
	T 48N R 32W	A3
	T _____ R _____	_____
	S _____ T _____ R _____	_____
2. Property Controlling in Section	S _____ T _____ R _____	_____
	S _____ T _____ R _____	_____
3. Miscellaneous Property in Sec.	S _____ T _____ R _____	_____
	S _____ T _____ R _____	_____

Register of Deeds Stamp & File Number

4. Lot No. _____, Recorded Plat _____
 5. Private Claims _____

Apr 27 2006

I, Stephan J. Szyszkoski, in a field survey on _____, 20____ do hereby state that under requirements of P.A. 74, Michigan P.A. of 1970, the corner points mentioned in lines 1 and 2 above were in conformance with regulations and rules therefore as required in the current manual of survey instructions of the United States Department of the Interior, Bureau of Land Management or by a decree of a Court of Law and /or that the corner points mentioned in lines 3, 4 and 5 above were in conformance with the rules of the Michigan Board of Land Surveyors or by a Decree of a Court of Law; established, re-established, monumented, recovered, found as expressed below:

	A	B	C	D	E	F	G	H	I	J	K	L	M
1													
2	6	5	4	3	2	1							
3	7	8	9	10	11	12							
4													
5													
6	18	17	16	15	14	13							
7													
8	19	20	21	22	23	24							
9													
10	30	29	28	27	26	25							
11													
12	31	32	33	34	35	36							
13													

NOTE: Not more than 2 corners, all in the same town and range, may be recorded on this certificate.

A. Description of original monument and accessories and/or subsequent restoration:


(A4) Quarter corner common to Section 7 T48N-R32W and Section 12 T48N-R33W. 1975 - Record dated Oct. 22 1975 by A.O.Enger RLS state that he reestablished the corner Dec. 7, 1973 on line between Section corners 40.704 chains to north and south. Set 1"IDx36" iron pipe with 3.5" aluminum cap. Tamarack 12 S75E 15.0', Tamarack 13 N24E 15.1'.
 (A3) Corner common to Sections 6 & 7 T48N-R32W and Sections 1 & 12 T48N-R33W. 1975 - Reestablished by K.L.Sackett RLS at "spot where old post stood. This post witnessed by Highway Department in 1944". Set 1"IDx36" iron pipe with 4" aluminum cap. Highway ROW post East 1.6'. Witnesses: 5" Maple S33W 21.1', 26" W.Pine N57W 50.9', 10" Maple S69E 11.2'.

B. Description of corner evidence found and/or method applied in restoring or reestablishing corner:

(A4) Recovered the 1973 monument, in good condition, and at substantial record bearing and distance from Mr. Enger's 1973 NBTs. I found this monument to be 76.5' north and 1.57' east of the midway position intended and described by Mr. Enger in the 1975 record. I conclude that Mr. Enger's determination of the position for the corner was erroneous and I did not accept the monumented position. I reestablished the corner midway and on a straight line between Section corners of record 2628.57' north and south. The position for the corner falls in a wet inaccessible area and was not monumented. I placed a Witness corner to A4 on the Section line 40.00' north of the corner position.
 (A3) Recovered the 1975 monument, leaning out of position, but otherwise in good condition. Plumbed the monument to best-fit record bearing and distance from the 1975 NBTs, the Maples found in good condition, and the W.Pine now a dead standing stub. Made the monument firm in a mound of stone. Made new witnesses as described below.

C. Description of monument for corner and accessories established to perpetuate locating the position of the corner:

(A4) Set 1"IDx32" I.pipe with 4" alum. MDNR cap for a WITNESS CORNER 40.00' north of the position for A4 and on the Section line. Set measuring nails in: 13" Tamarack N11E 51.1' mrkd "WC BT" * 17" Tamarack N30E 34.7' do * 3" Tamarack East 35.6' do 10" twin Spruce N64W 18.1' do Bearings are magnetic. Distances are to nail with tag. * denotes 1973 NBT.	(A3) Found 1"ID I.pipe with 4" alum. MDNR cap. Set measuring nails in: 12" Maple S64E 11.5' old scribing * 7" Maple S38W 21.3' do * 6" Maple N78W 10.5' mrkd "S2 NBT" 5" Maple in clump N29E 19.9' "S6 NBT" Concrete ROW post East 1.8' Bearings are magnetic. Distances to trees are to nail with tag. * denotes 1975 NBT.
---	---

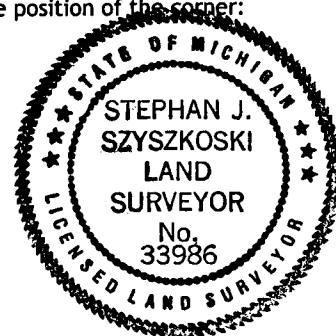

Signed by Stephan J. Szyszkoski
 Surveyor's Michigan License No. 33986

Date 9/12/06