

LAND CORNER RECORDATION CERTIFICATE
Filing Requirement of Act 74, Mich. P.A. 1970 as Amended

For corners in

<u>Baraga</u> (County)	Located In:	Corner Code #
1. Public Land Survey	<u>T48N R 32W</u>	<u>F11</u>
	<u>T48N R 32W</u>	<u>E13</u>
	T ___ R ___	_____
	S ___ T ___ R ___	_____
2. Property Controlling in Section	S ___ T ___ R ___	_____
	S ___ T ___ R ___	_____
3. Miscellaneous Property in Sec.	S ___ T ___ R ___	_____
	S ___ T ___ R ___	_____
4. Lot No. _____, Recorded Plat _____		
5. Private Claims		

Register of Deeds Stamp & File
Number

	A	B	C	D	E	F	G	H	I	J	K	L	M
1													
2	6		5		4		3		2		1		
3													
4	7		8		9		10		11		12		
5													
6	18		17		16		15		14		13		
7													
8	19		20		21		22		23		24		
9													
10	30		29		28		27		26		25		
11						●							
12	31		32		33		34		35		36		
13						●							

E13 Oct 31 2007
F11 Nov 01 2007

I, Stephan J. Szyszkoski, in a field survey on _____, 20__ do hereby state that under requirements of P.A. 74, Michigan P.A. of 1970, the corner points mentioned in lines 1 and 2 above were in conformance with regulations and rules therefore as required in the current manual of survey instructions of the United States Department of the Interior, Bureau of Land Management or by a decree of a Court of Law and /or that the corner points mentioned in lines 3, 4 and 5 above were in conformance with the rules of the Michigan Board of Land Surveyors or by a Decree of a Court of Law; established, re-established, monumented, recovered, found as expressed below:

NOTE: Not more than 2 corners, all in the same town and range, may be recorded on this certificate.


A. Description of original monument and accessories and/or subsequent restoration:
 (F11) Quarter corner common to Sections 28 and 33. 1852 - Established by Guy Carleton, Deputy Surveyor, midway and on the Section line between Section corners 39.935 chains east and west. Set post. Sugar 10 N15W 88 links, Sugar 12 S35E 74 links.

(E13) Corner common to Sections 32-33 T48N-R32W and Sections 4-5 T47N-R32W. 1846 - Established by Wm.A.Burt, Deputy Surveyor. Set maple post. Cedar 14 N70E 7 links, Cedar 16 N54W 15 links. 1960 - Corner perpetuated by Neal Sperhake RLS with 1"x36" iron pipe with Kimberly-Clark Corp. cap placed from original bearing tree Cedar 14 N70E 7 links. NBTs: Maple 9" N60W 52.5 links, Maple 7 N72E 84 links, Maple 14" S62E 85.5 links, Maple 7 S78W 80 links.

B. Description of corner evidence found and/or method applied in restoring or reestablishing corner:
 (F11) The original post and accessories were not recovered. Found no evidence of the position of the original corner on the ground. Reestablished the corner midway and on the Section line between Section corners 2632.35' east and west.

(E13) Found the 1960 monument in good condition and at record bearing and distance from NBT Sugars NE and SE. The distance to SE NBT 85.5 links appears to have been transposed in the record from the correct 58.5 links, at which distance it was found. The original BT Cedar NE is still in place, 28" DBH with old blazes and many signatures. Accepted the monument as a careful and faithful perpetuation of the position of the original corner.

C. Description of monument for corner and accessories established to perpetuate locating the position of the corner:
 (F11) Set 1"IDx32" I.pipe with 4" alum. MDNR cap. Set measuring nail with MDNR tag in the side of:
 9" Sugar N11E 43.3' mrkd "1/4S NBT"
 15" Sugar N65E 24.5' do
 5" Sugar S53E 45.75' do
 11" Sugar N70W 38.2' do
 Set sq'd cedar post adjacent. Bearings are magnetic.
 (E13) Found 1"ID I.pipe with 4" alum. Kimberly-Clark Corp. cap RLS 7876. Set measuring nail with MDNR tag in the side of the following:
 28" Cedar N70E 5.6' old blazes (the OBT)
 9" Sugar N79E 55.4' overgrown blazes (1960 NBT)
 16" Sugar S60E 38.7' do do
 4" Sugar N80W 18.4' mrkd "S32 NBT"
 Set sq'd cedar post adjacent. Bearings are magnetic.

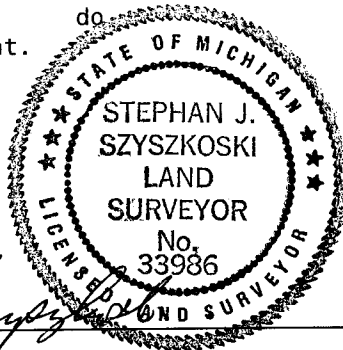

Signed by Stephan J. Szyszkoski Date 11/26/07

Surveyor's Michigan License No. 33986