

LAND CORNER RECORDATION CERTIFICATE
Filing Requirement of Act 74, Mich. P.A. 1970 as Amended

For corners in

<u>Baraga</u> (County)	Located In:	Corner Code #
1. Public Land Survey	T48N R 32W	G11
	T48N R 32W	F13
	T R	
2. Property Controlling in Section	S T R	
	S T R	
3. Miscellaneous Property in Sec.	S T R	
	S T R	
4. Lot No. _____, Recorded Plat _____		
5. Private Claims		

Register of Deeds Stamp & File Number

	A	B	C	D	E	F	G	H	I	J	K	L	M
1													
2	6		5		4		3		2		1		
3													
4	7		8		9		10		11		12		
5													
6	18		17		16		15		14		13		
7													
8	19		20		21		22		23		24		
9													
10	30		29		28		27		26		25		
11													
12	31		32		33		34		35		36		
13													

I, Stephan J. Szyszkoski, in a field survey on Nov 01, 2007 do hereby state that under requirements of P.A. 74, Michigan P.A. of 1970, the corner points mentioned in lines 1 and 2 above were in conformance with regulations and rules therefore as required in the current manual of survey instructions of the United States Department of the Interior, Bureau of Land Management or by a decree of a Court of Law and /or that the corner points mentioned in lines 3, 4 and 5 above were in conformance with the rules of the Michigan Board of Land Surveyors or by a Decree of a Court of Law; established, re-established, monumented, recovered, found as expressed below:

NOTE: Not more than 2 corners, all in the same town and range, may be recorded on this certificate.

A. Description of original monument and accessories and/or subsequent restoration:

(G11) Corner common to Sections 27-28-33-34. 1852 - Established by Guy Carleton, Deputy Surveyor. Set post. Yellow Birch 14 N60W 20 links, White Pine 12 S75E 43 links.

(F13) Quarter corner common to Section 33 T48N-R32W and Section 4 T47N-R32W. 1846 - Established by Wm.A.Burt, Deputy Surveyor, midway and on the Township line between Section corners 40.00 chains east and west. Set Fir post. Maple 4 N75E 9 links, Cedar 12 N41W 21 links. 1960 - Corner remonumented by Neal Sperhake RLS from original BT Cedar 12 N41W 21 links. Set 1"IDx36" iron pipe with 4" alum. Kimberly-Clark Corp. cap. NBTs: Cedar 18" N30W 40 links, Cedar 10" S24E 50 links.

B. Description of corner evidence found and/or method applied in restoring or reestablishing corner:


(G11) The original post and accessories were not recovered. Found no evidence of the position of the original corner on the ground. Reestablished the corner by double proportionate measurement to the original record between Section corner 15545.17' west, Section corner 10545.79' north, Section corner 5272.91' south, and Quarter corner 7942.87' east.

(F13) Found the 1960 monument of record in good condition and at record bearing and distance from the 1960 NBTs: Cedar 18" N30W 40 links, now 21" DBH with double overgrown blazes, Cedar 10" S24E 50 links, now 16" DBH with double overgrown blazes. The OBT Cedar 12" N41W 21 links is now 16" DBH with an exposed face with scribing visible. The tree is still alive but its top is broken about 25' above the ground. Accepted the 1960 monument as a careful and faithful perpetuation of the position of the original corner.

C. Description of monument for corner and accessories established to perpetuate locating the position of the corner:

(G11) Set 1"IDx32" I.pipe with 4" alum. MDNR cap. Set measuring nail with MDNR tag in the side of:
 20" W.Pine N43E 26.0' mrkd "S27 NBT"
 18" W.Pine S07E 20.05' "S34 NBT"
 19" W.Pine S85W 15.8' "S33 NBT"
 11" Spruce N05W 28.35' "S28 NBT"
 Set sq'd cedar post adjacent.
 Bearings are magnetic.

(F13) Found 1"ID iron pipe with 4" alum. Kimberly-Clark Corp. cap RLS 7876. Set measuring nail with MDNR tag in the following:
 16" Cedar N37W 14.95' scribing visible (orig. BT)
 21" Cedar N24W 25.9' overgrown blazes (1960 NBT)
 16" Cedar S16E 32.7' do do
 13" Cedar S38W 38.0' mrkd "1/4S NBT"
 Bearings are magnetic.
 Set sq'd cedar post adjacent.

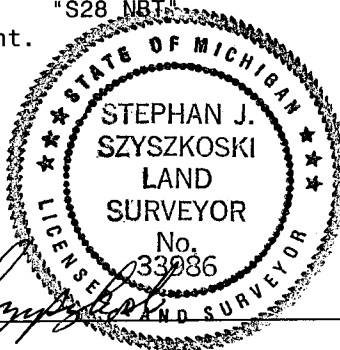

Signed by Stephan J. Szyszkoski Date 11/26/07

Surveyor's Michigan License No. 33986