


LAND CORNER RECORDATION CERTIFICATE
Filing Requirement of Act 74, Mich. P.A. 1970 as Amended

For corners in

Baraga	Located In:	Corner Code #
(County)		
1. Public Land Survey	T48N R 32W	G13
	T48N R 32W	G12
	T _____ R _____	_____
	S _____ T _____ R _____	_____
2. Property Controlling in Section	S _____ T _____ R _____	_____
	S _____ T _____ R _____	_____
3. Miscellaneous Property in Sec.	S _____ T _____ R _____	_____
	S _____ T _____ R _____	_____
4. Lot No. _____, Recorded Plat _____		
5. Private Claims		

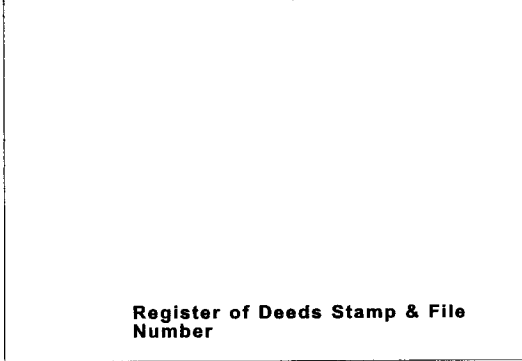

	A	B	C	D	E	F	G	H	I	J	K	L	M
1													
2	6		5		4		3		2		1		
3													
4	7		8		9		10		11		12		
5													
6	18		17		16		15		14		13		
7													
8	19		20		21		22		23		24		
9													
10	30		29		28		27		26		25		
11													
12	31		32		33		34		35		36		
13													

I, Stephan J. Szyszkoski, in a field survey on Oct 30, 2007 do hereby state that under requirements of P.A. 74, Michigan P.A. of 1970, the corner points mentioned in lines 1 and 2 above were in conformance with regulations and rules therefore as required in the current manual of survey instructions of the United States Department of the Interior, Bureau of Land Management or by a decree of a Court of Law and /or that the corner points mentioned in lines 3, 4 and 5 above were in conformance with the rules of the Michigan Board of Land Surveyors or by a Decree of a Court of Law; established, re-established, monumented, recovered, found as expressed below:

NOTE: Not more than 2 corners, all in the same town and range, may be recorded on this certificate.

A. Description of original monument and accessories and/or subsequent restoration:
 (G13) Corner common to Sections 33-34 T48N-R32W and Sections 3-4 T47N-R32W. 1846 - Established by Wm.A.Burt, Deputy Surveyor. Set Fir post in west side of swamp, C NNW. W.Pine 24 N38E 37 links, Spruce 12 N45W 21 links. Found no subsequent record.


(G12) Quarter corner common to Sections 33 and 34. 1852 - Established by Guy Carleton, Deputy Surveyor, midway and on the Section line between Section corners 40.05 chains north and south. Set post. Yellow Birch 12 S31E 35 links, Yellow Birch 8 S67W 22 links. Found no subsequent record.

B. Description of corner evidence found and/or method applied in restoring or reestablishing corner:
 (G13) The original post and accessories were not recovered. Found no evidence of the position of the original corner on the ground. Reestablished the corner by single proportionate measurement to the original record and on the Township line between Quarter corner 2639.58' west and Township corner 15837.51' east.

(G12) The original post and accessories were not recovered. Found no acceptable evidence of the position of the original corner on the ground. Reestablished the corner midway and on the Section line between Section corners 2636.45' north and south.

C. Description of monument for corner and accessories established to perpetuate locating the position of the corner:
 (G13) Set 1"IDx32" I.pipe with 4" alum. MDNR cap. Set measuring nail with MDNR tag in the side of:
 6" Spruce N26E 13.5' mrkd "S34 NBT"
 10" Spruce S11E 5.2' "S3 NBT"
 4" Spruce S45W 28.2' "S4 NBT"
 7" Maple N40W 17.4' "S33 NBT"
 Set sq'd cedar post adjacent. Bearings are magnetic.

(G12) Set 1"IDx32" I.pipe with 4" alum. MDNR cap in a mound of rock 5'x2'x1' high. Set measuring nail with MDNR tag in the side of the following:
 6" Spruce N75E 31.9' mrkd "1/4S NBT"
 8" Sugar S23E 18.4' do
 8" Sugar S58W 16.8' do
 8" Sugar N07W 12.2' do
 Set sq'd cedar post adjacent. Bearings are magnetic.

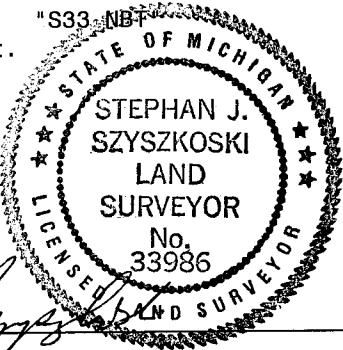

Signed by Stephan J. Szyszkoski Date 11/26/07

Surveyor's Michigan License No. 33986