

**LAND CORNER RECORDATION CERTIFICATE**  
**Filing Requirement of Act 74, Mich. P.A. 1970 as Amended**

For corners in

|                                       |                      |               |
|---------------------------------------|----------------------|---------------|
| <u>Baraga</u><br>(County)             | Located In:          | Corner Code # |
| 1. Public Land Survey                 | T48N R 32W           | H13           |
|                                       | T48N R 32W           | H11           |
|                                       | T_____ R_____        | _____         |
|                                       | S_____ T_____ R_____ | _____         |
| 2. Property Controlling in Section    | S_____ T_____ R_____ | _____         |
|                                       | S_____ T_____ R_____ | _____         |
| 3. Miscellaneous Property in Sec.     | S_____ T_____ R_____ | _____         |
|                                       | S_____ T_____ R_____ | _____         |
| 4. Lot No. _____, Recorded Plat _____ |                      |               |
| 5. Private Claims                     |                      |               |

Register of Deeds Stamp & File Number

| A  | B  | C  | D  | E  | F  | G  | H | I | J | K | L | M |
|----|----|----|----|----|----|----|---|---|---|---|---|---|
| 1  |    |    |    |    |    |    |   |   |   |   |   |   |
| 2  | 6  | 5  | 4  | 3  | 2  | 1  |   |   |   |   |   |   |
| 3  |    |    |    |    |    |    |   |   |   |   |   |   |
| 4  | 7  | 8  | 9  | 10 | 11 | 12 |   |   |   |   |   |   |
| 5  |    |    |    |    |    |    |   |   |   |   |   |   |
| 6  | 18 | 17 | 16 | 15 | 14 | 13 |   |   |   |   |   |   |
| 7  |    |    |    |    |    |    |   |   |   |   |   |   |
| 8  | 19 | 20 | 21 | 22 | 23 | 24 |   |   |   |   |   |   |
| 9  |    |    |    |    |    |    |   |   |   |   |   |   |
| 10 | 30 | 29 | 28 | 27 | 26 | 25 |   |   |   |   |   |   |
| 11 |    |    |    |    |    |    | ● |   |   |   |   |   |
| 12 | 31 | 32 | 33 | 34 | 35 | 36 |   |   |   |   |   |   |
| 13 |    |    |    |    |    |    | ● |   |   |   |   |   |

H13 Nov 01 2007  
H11 Oct 31 2007

I, Stephan J. Szyszkoski, in a field survey on \_\_\_\_\_, 20\_\_\_\_ do hereby state that under requirements of P.A. 74, Michigan P.A. of 1970, the corner points mentioned in lines 1 and 2 above were in conformance with regulations and rules therefore as required in the current manual of survey instructions of the United States Department of the Interior, Bureau of Land Management or by a decree of a Court of Law and /or that the corner points mentioned in lines 3, 4 and 5 above were in conformance with the rules of the Michigan Board of Land Surveyors or by a Decree of a Court of Law; established, re-established, monumented, recovered, found as expressed below:

**NOTE: Not more than 2 corners, all in the same town and range, may be recorded on this certificate.**

**A. Description of original monument and accessories and/or subsequent restoration:**

(H13) Quarter corner common to Section 34 T48N-R32W and Section 3 T47N-R32W. 1846 - Established by Wm.A.Burt, Deputy Surveyor, midway and on the Township line between Section corners 40.00 chains east and west. Set Pine post. Tamarack 14 N59E 14 links, Y.Pine 14 N31W 13 links. Found no subsequent record.

(H11) Quarter corner common to Sections 27 and 34. 1852 - Established by Guy Carleton, Deputy Surveyor, midway and on the Section line between Sections corners 40.30 chains east and west. Set post. Tamarack 12 N23E 23 links, White Birch 7 S35E 52 links. Found no subsequent record.


**B. Description of corner evidence found and/or method applied in restoring or reestablishing corner:**

(H13) The original post and accessories were not recovered. Found no acceptable evidence of the position of the original corner on the ground. Reestablished the corner by single proportionate measurement to the original record, midway and on the Township line between reestablished Section corners 2639.58' east and west. From the position thus established, I found a 1" square iron bar, not of record, set by persons unknown, projecting about 2 ft. and leaning NE, N20W 37 ft. distant, which I did not accept as marking the position for the corner.

(H11) The original post and accessories were not recovered. Found no evidence of the position of the original corner on the ground. Reestablished the corner midway and on the Section line between Section corners 2656.11' east and west.

**C. Description of monument for corner and accessories established to perpetuate locating the position of the corner:**

|  |   |
|--|---|
| (H13) Set 1"IDx32" I.pipe with 4" alum. MDNR cap.<br>Set measuring nail with MDNR tag in the side of:<br>10" Y.Birch N45E 10.1' mrkd "1/4S NBT"<br>5" Sugar S65E 16.3' do<br>7" Y.Birch S63W 26.5' do<br>11" Y.Birch N33W 24.45' do<br>Set sq'd cedar post adjacent.<br>Bearings are magnetic. | (H11) Set 1"IDx32" I.pipe with 4" alum. MDNR cap.<br>Set measuring nail with MDNR tag in the side of:<br>5" Spruce N64E 3.6' mrkd "1/4S NBT"<br>6" W.Birch S19E 11.5' do<br>4" Spruce N83W 17.7' do<br>3" Balsam N29W 18.7' do<br>Set sq'd cedar post adjacent.<br>Bearings are magnetic. |
|--|---|

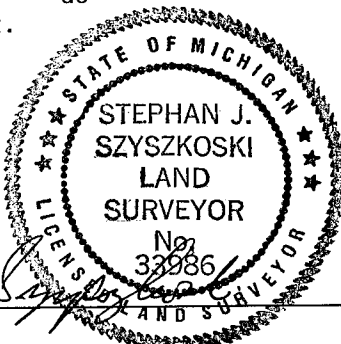

Signed by Stephan J. Szyszkoski Date 11/26/07

Surveyor's Michigan License No. 33986