

**LAND CORNER RECORDATION CERTIFICATE**  
**Filing Requirement of Act 74, Mich. P.A. 1970 as Amended**

For corners in

<u>Baraga</u> (County)	Located In:	Corner Code #
1. Public Land Survey	<u>T48N R 32W</u>	<u>I12</u>
	<u>T48N R 32W</u>	<u>I11</u>
	T _____ R _____	_____
2. Property Controlling in Section	S _____ T _____ R _____	_____
	S _____ T _____ R _____	_____
3. Miscellaneous Property in Sec.	S _____ T _____ R _____	_____
	S _____ T _____ R _____	_____
4. Lot No. _____, Recorded Plat _____		
5. Private Claims		

Register of Deeds Stamp & File  
Number

	A	B	C	D	E	F	G	H	I	J	K	L	M
1													
2	6	5	4	3	2	1							
3													
4	7	8	9	10	11	12							
5													
6	18	17	16	15	14	13							
7													
8	19	20	21	22	23	24							
9													
10	30	29	28	27	26	25							
11									●				
12	31	32	33	34	35	36			●				
13													

I, Stephan J. Szyszkoski, in a field survey on Oct 23, 2007 do hereby state that under requirements of P.A. 74, Michigan P.A. of 1970, the corner points mentioned in lines 1 and 2 above were in conformance with regulations and rules therefore as required in the current manual of survey instructions of the United States Department of the Interior, Bureau of Land Management or by a decree of a Court of Law and /or that the corner points mentioned in lines 3, 4 and 5 above were in conformance with the rules of the Michigan Board of Land Surveyors or by a Decree of a Court of Law; established, re-established, monumented, recovered, found as expressed below:

**NOTE: Not more than 2 corners, all in the same town and range, may be recorded on this certificate.**

**A. Description of original monument and accessories and/or subsequent restoration:**

(I12) Quarter corner common to Sections 34-35. 1852 - Established by Guy Carleton Deputy Surveyor, midway and on the Section line between Section corners 40.06 chains north and south. Set post. Fir 8 S75W 15 links, Yellow Birch 18 N28E 10 links. Found no subsequent record.

(I11) Corner common to Sections 26-27-34-35. 1852 - Established by Guy Carleton, Deputy Surveyor. Set post. Spruce 10 N73E 17 links, Spruce 10 S25W 15 links. Found no subsequent record.

**B. Description of corner evidence found and/or method applied in restoring or reestablishing corner:**


(I12) The original post and accessories were not recovered. Found no evidence of the position of the original corner on the ground. Reestablished the corner midway and on the Section line between reestablished Section corners 2627.36' north and south.

(I11) The original post and accessories were not recovered. Found no evidence of the position of the original corner on the ground. Reestablished the corner by double proportionate measurement to the original record between Section corner 5254.53' north, Section corner 5254.73' south, Quarter corner 2630.93' east, and Section corner 20,857.36' west.

**C. Description of monument for corner and accessories established to perpetuate locating the position of the corner:**

(I12) Set 1"IDx32" I.pipe with 4" alum. MDNR cap. Set measuring nail with MDNR tag in the side of:  
 10" Balsam S83W 49.2' mrkd "1/4S NBT"  
 4" Balsam N76W 40.8' do  
 11" Maple N40W 74.3' do  
 4" W.Spruce N20W 62.2' do  
 Set sq'd spruce post adjacent.  
 Bearings are magnetic.

(I11) Set 1"IDx32" I.pipe with 4" alum. MDNR cap. Set measuring nail with MDNR tag in the side of:  
 11" B.Spruce N17E 10.6' mrkd "S26 NBT"  
 4" B.Spruce S59E 14.8' "S35 NBT"  
 3" Maple S71W 5.3' "S34 NBT"  
 4" Y.Birch N67W 13.9' "S27 NBT"  
 Set sq'd cedar post adjacent.  
 Bearings are magnetic.

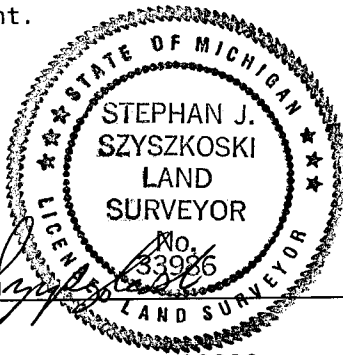

Signed by Stephan J. Szyszkoski Date 11/26/07

Surveyor's Michigan License No. 33986