

LAND CORNER RECORDATION CERTIFICATE
Filing Requirement of Act 74, Mich. P.A. 1970 as Amended

For corners in

<u>Baraga</u> (County)	Located In:	Corner Code #
1. Public Land Survey	T ___ R _____	_____
	T ___ R _____	_____
	T ___ R _____	_____
	S <u>34</u> T <u>48N</u> R <u>32W</u>	<u>11</u>
2. Property Controlling in Section	S <u>34</u> T <u>48N</u> R <u>32W</u>	<u>H12</u>
	S ___ T ___ R _____	_____
3. Miscellaneous Property in Sec.	S ___ T ___ R _____	_____
	S ___ T ___ R _____	_____
4. Lot No. _____, Recorded Plat _____		
5. Private Claims		

Register of Deeds Stamp & File Number

	A	B	C	D	E	F	G	H	I	J	K	L	M
1													
2	6	5	4	3	2	1							
3													
4	7	8	9	10	11	12							
5													
6	18	17	16	15	14	13							
7													
8	19	20	21	22	23	24							
9													
10	30	29	28	27	26	25							
11													
12	31	32	33	34	35	36							
13													

I, Stephan J. Szyszkoski, in a field survey on Oct 24, 2007 do hereby state that under requirements of P.A. 74, Michigan P.A. of 1970, the corner points mentioned in lines 1 and 2 above were in conformance with regulations and rules therefore as required in the current manual of survey instructions of the United States Department of the Interior, Bureau of Land Management or by a decree of a Court of Law and /or that the corner points mentioned in lines 3, 4 and 5 above were in conformance with the rules of the Michigan Board of Land Surveyors or by a Decree of a Court of Law; established, re-established, monumented, recovered, found as expressed below:

NOTE: Not more than 2 corners, all in the same town and range, may be recorded on this certificate.


A. Description of original monument and accessories and/or subsequent restoration:
 (H12) Center of Section 34. Not established in the original survey.

(11-Sec. 34) Southwest 1/16 corner, Section 34. Not established in the original survey.

B. Description of corner evidence found and/or method applied in restoring or reestablishing corner:
 (H12) Established the corner at the intersection of straight lines connecting opposite 1/4 corners.

(11-Sec. 34) Established the corner at the intersection of straight lines connecting opposite 1/16 corners. From the position thus established, I found a 1" square iron pin, not of record, placed by persons unknown, S19W 60.3' distant, which I did not accept as marking the position for the corner.

C. Description of monument for corner and accessories established to perpetuate locating the position of the corner:	(11) Set 1"IDx32" I.pipe with 4" alum. MDNR cap.
(H12) Set 1"IDx32" I.pipe with 4" alum. MDNR cap.	Set measuring nail with MDNR tag in the side of:
Set measuring nail with MDNR tag in the side of:	Set measuring nail with MDNR tag in the side of:
6" B.Spruce N04W 13.7' mrkd "C1/4 BT"	6" Sugar N24E 11.8' mrkd "1/16S BT"
5" B.Spruce N77E 14.0' do	8" Sugar S74E 28.4' do
4" Tamarack S50E 24.3' do	9" Sugar S27E 13.0' do
3" B.Spruce S85W 19.5' do	8" Sugar N43W 7.3' do
Set sq'd cedar post adjacent.	Set sq'd cedar post adjacent.
Bearings are magnetic.	Bearings are magnetic.

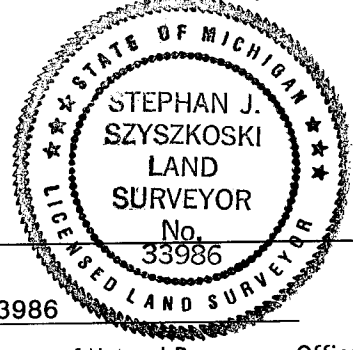

Signed by Stephan J. Szyszkoski Date 11/15/07

Surveyor's Michigan License No. 33986