

LAND CORNER RECORDATION CERTIFICATE
Filing Requirement of Act 74, Mich. P.A. 1970 as Amended

For corners in

<u>Baraga</u> (County)	Located In:	Corner Code #
1. Public Land Survey	T ___ R ___	_____
	T ___ R ___	_____
	T ___ R ___	_____
	S 34 T 48N R 32W	10
2. Property Controlling in Section	S 34 T 48N R 32W	15
	S ___ T ___ R ___	_____
3. Miscellaneous Property in Sec.	S ___ T ___ R ___	_____
	S ___ T ___ R ___	_____
4. Lot No. _____, Recorded Plat _____		
5. Private Claims		

Register of Deeds Stamp & File Number

I, Stephan J. Szyszkoski, in a field survey on Oct 30, 2007 do hereby state that under requirements of P.A. 74, Michigan P.A. of 1970, the corner points mentioned in lines 1 and 2 above were in conformance with regulations and rules therefore as required in the current manual of survey instructions of the United States Department of the Interior, Bureau of Land Management or by a decree of a Court of Law and /or that the corner points mentioned in lines 3, 4 and 5 above were in conformance with the rules of the Michigan Board of Land Surveyors or by a Decree of a Court of Law; established, re-established, monumented, recovered, found as expressed below:

NOTE: Not more than 2 corners, all in the same town and range, may be recorded on this certificate.

A	B	C	D	E	F	G	H	I	J	K	L	M
1												
2	6	5	4	3	2	1						
3												
4	7	8	9	10	11	12						
5												
6	18	17	16	15	14	13						
7												
8	19	20	21	22	23	24						
9												
10	30	29	28	27	26	25						
11												
12	31	32	33	34	35	36						
13												

A. Description of original monument and accessories and/or subsequent restoration:
 (10-Sec. 34) South 1/16 corner between Sections 33 and 34. Not established in the original survey.


(15-Sec. 34) West 1/16 corner between Section 34 T48N-R32W and Section 3 T47N-R32W. Not established in the original survey.

B. Description of corner evidence found and/or method applied in restoring or reestablishing corner:
 (10-Sec. 34) Established the corner midway and on the Section line between Quarter corner 1318.23' north and Section corner 1318.23' south.

(15-Sec. 34) Established the corner midway and on the Township line between Section corner 1319.79' west and Quarter corner 1319.79' east.

C. Description of monument for corner and accessories established to perpetuate locating the position of the corner:
 (10) Set 1"IDx40" I.pipe with 4" alum. MDNR cap. Set measuring nail with MDNR tag in the side of:
 16" Cedar S77E 16.0' mrkd "S1/16 BT"
 17" Cedar S58W 33.6' do
 13" Y.Birch N85W 22.1' do
 13" Cedar N35W 7.8' do
 Set sq'd cedar post adjacent.
 Bearings are magnetic.

(15) Set 1"IDx32" I.pipe with 4" alum. MDNR cap. Set measuring nail with MDNR tag in the side of:
 2" B.Spruce S04E 26.1' mrkd "X X"
 2" B.Spruce S87W 30.8' do
 No other trees near.
 Set sq'd cedar post adjacent.

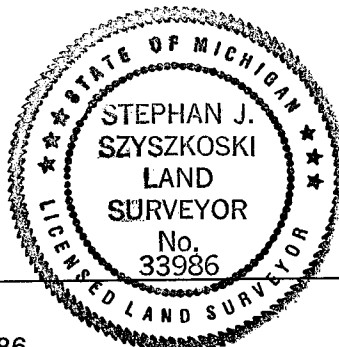

Signed by Stephan J. Szyszkoski Date 11/15/07

Surveyor's Michigan License No. 33986

For the Michigan Department of Natural Resources, Office of Land and Facilities