

LAND CORNER RECORDATION CERTIFICATE

FILING REQUIREMENT OF ACT 74, MICH. P.A.1970

FOR CORNERS OF--	LOCATED IN--	CORNER CODE NUMBER	
1. PUBLIC LAND SURVEY _____	T. <u>48</u> ^{N.} / _{S.} , R. <u>33</u> ^{E.} / _{W.}	<u>C-1, E-1, E-2</u>	REGISTER OF DEEDS STAMP AND FILING NUMBER
2. PROPERTY CONTROLLING IN SECTION <u>4</u>	, T. <u>48</u> ^{N.} / _{S.} , R. <u>33</u> ^{E.} / _{W.}	<u>10</u>	
3. MISCELLANEOUS PROPERTY IN SECTION _____	, T. _____ ^{N.} / _{S.} , R. _____ ^{E.} / _{W.}	_____	
4. LOT NO. _____	, RECORDED PLAT _____	_____	
5. PRIVATE CLAIMS _____	_____	_____	

I, Keith L. Sackett, do hereby certify that under requirements of P.A. 74, Michigan P.A. of 1970, the corner points mentioned in lines 1 and 2 above were, in a field survey on July 27, 19 76, established, re-established, monumented, re-monumented, recovered or restored as expressed below and in conformance with regulations and rules therefore as required in the current manual of survey instructions of the United States Department of the Interior, Bureau of Land Management or by a decree of a court of law. Furthermore, that the corner points mentioned in lines 3, 4 and 5 above were, in a field survey on _____, 19____, found, recovered, restored, established or re-established as expressed below and in conformance with the rules of the Michigan State Board of Registration for Land Surveyors or, by a Decree of a Court of law:

A. Description of original monument and accessories and/or subsequent restoration:

- Corner C-1: Original monument and accessories not found. Found 1" I.D. iron pipe 18" above ground in a pile of rocks.
- Corner E-1: Original monument and accessories not found. Found an old scribed post believed to have been set by Norman Thompson, R.L.S.
- Corner E-2: Original monument and accessories not found. Found 1 1/2" I.D. on pipe 38" long with post.
- Corner 10: Found 1 1/2" I.D. iron pipe 3 1/2 ft. long with scribed post. Believed to have been set by Norman Thompson, R. L. S.

B. Description of corner evidence found and/or method applied in restoring or re-establishing corner:

- Corner C-1: Re-established at iron pipe. Fits good with other corners in area.
- Corner E-1: Re-established corner at post location. Fits good with other corners in the area.
- Corner E-2: Re-established at pipe location. Fits good with corners north and south.
- Corner 10: Re-established corner at pipe location.

C. Description of monument for corner and accessories established to perpetuate locating the position of the corner:

- | | |
|---|---|
| <p><u>Corner C-1:</u> 1" I.D. iron pipe 18" above ground in pile of rocks.</p> <p>5" Sugar N65°W 25.3 ft. S31, NBT</p> <p>5" Sugar S28°E 13.9 ft. S 5, NBT</p> <p>6" Sugar N35°E 39.4 ft. S32, NBT</p> | <p><u>Corner E-2:</u> Set 1" I.D. x 36" iron pipe with 4" aluminum cap.</p> <p>4" Spruce S42°E 22.5' 1/4S, NBT</p> <p>8" Tamarack N19°W 33.3' 1/4S, NBT</p> <p>6" W. Pine S75°W 21.7' 1/4S, NBT</p> |
| <p><u>Corner E-1:</u> Set 1" I.D. x 36" iron pipe with 4" aluminum cap.</p> <p>8" Maple S32°W 5.1' S 5, NBT</p> <p>16" Cedar S68°E 6.2' S 4, NBT</p> <p>12" Y. Birch N62°W 13.7' S32, NBT</p> <p>16" Cedar with beaver N81°E, 10.1'</p> | <p><u>Corner 10:</u> Set 1" I.D. x 36" iron pipe with 4" aluminum cap.</p> <p>3" Spruce S25°W 24.6' 1/16S, BT</p> <p>2" Spruce S67°E 14.5' 1/16S, BT</p> |
- SIGNED BY _____ DATE _____


SURVEYOR'S MICHIGAN REGISTRATION NO. _____

(SEAL)

FOR STATE AND UNITED STATES AGENCIES:

SIGNED BY _____ DATE _____

APPROVED AND SIGNED BY Keith L. Sackett DATE August 5, 1976
CHIEF OF SURVEY PARTY
MICHIGAN REGISTERED LAND SURVEYOR
Keith L. Sackett

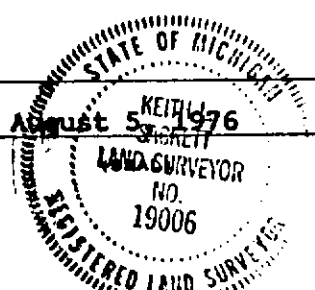

SURVEYOR'S MICHIGAN REGISTRATION NO. 19006