
LAND CORNER RECORDATION CERTIFICATE

FILING REQUIREMENT OF ACT 74, MICH. P.A.1970

FOR CORNERS OF -:	LOCATED IN-	: '	CORNER CODE NUMBER	1
1. PUBLIC LAND SURV	VEY T. 48 %. F	. 33 K.	M2, M3, L3	
2. PROPERTY CONTROLLING IN SECT	OLL- TION, T. 48 N.	. 33 K. W.	16	
2 3400000 1 43300000	rion , T S., R	1		,
4. LOT NO	, RECORDED PLAT			
5. PRIVATE CLAIMS				REGISTER OF DEEDS STAMP AND
I. Keith L. S.	ackett			FILING NUMBER
the corner points mer field survey onS	ntioned in lines 1 and 2 a	ibove (identi established,	fied with circles on index re-established, monumente	P.A. 74, Michigan P.A. of 1970, code diagram – over) were, in a d, re-monumented, recovered or
of survey instructions court of law. Fur	l below and in conformance of the United States Dep thermore, that the corner	with regula artment of th points men	ctions and rules therefore as e Interior, Bureau of Land I ationed in lines 3,4 and 5 a	s required in the current manual Management or by a decree of a above were, in a field survey on
	. 19, found, recovered,	restored, est	ablished or re-established :	as expressed below and in consor, by a Decree of a Court of
	:1 1			
Corners M2, M	inal monument and access 3, L3: Original mon	ories and/or nument or	r subsequent restoration: accessories not four	d.
Corner 16: No	ot set on original s	urvey or	subsequently apparen	tly.
•				
•	•			
B. Description of corn	ner evidence found and/or	method onni	ed in restoring or re-estable	*- 1. *
Corner M2: Re-		on line	between section corn	
	established 5-19-75 cnessed by Highway I		pot where old post s in 1944.	tood. This post
Corner 13: Re-	-established 4-25-75	on line	between section corn	ers.
Corner 16: Est C. Description of mon	ablished 4-24-75 or	line bet	ween section corner ablished to perpetuate locat	east and 1 corner west. ing the position of the corner:
Corner M2: Set 1" with 4" aluminum	' I.D. x 36" Iron Pi		orner L3: Set 1" I.	D. x 36" Iron Pipe with orner is 65 ft. south of
24" W. Pine S750	E (Mag.) 30.9 ft. } (Mag.) 48.6 ft. }s,	s, nbt Nbt	g US-41. 7" Cedar SO5°W (Mag	
Corner M3: Set 1"	' I.D. x 36" Iron Pi	ne .	10" Cedar 586°W (Ma	g.) 66.0 ft $\frac{1}{2}$ S, NBT
with 4" aluminum	cap. Highway row	post <u>C</u>		D. x 36" Iron Pipe with 4"
east 1.6 ft. 5" Marle 3330W (Mag.) 21.1 ft. S12,	NBT	aluminum cap	.) 42.2 ft. 1/16 S. BT
26" W. Pine N579	W(Mag.) 50.9 ft. Sl, (Mag.) 11.2 ft. S7,	NBT	6" Balsam S16°E (Ma	g.) 16.5 ft. 1/16 S, BT
SIGNED BY			DATE	
SURVEYOR'S MICHIGA	AN REGISTRATION NO			(SEAL)
FOR STATE AND UNIT	TED STATES AGENCIES:			MATE OF MICHAEL
SIGNED BY	CHIEF, OF BURYSY PA	177	DATE	VERTO .
Approved and sign	TO MY LE SUFFICION THE OR HELD	เลาะเลา โลลี ซึ่ เอง	<u>*</u>	MIND SURVEYOR
	Pepartment of		desources	19006
SURVEYOR'S MICHIGAT	N REGISTRATION NO	FORM APP	ROVED BY MICHIGAN STATE BOARS	DO REGISTRATION, JAN. 26, 1971
,		остани	TO BY MICHGAN SOLIFTY OF BE	GISTERIN LAND CHARACES


CORNER NUMBERING CODE DIAGRAMS FOR IDENTIFYING LAND CORNER RECORDATIONS AND INDEXING

FOR PUBLIC LAND SURVEY CORNERS IN THE T. 450, R. 3312 (MENTIONED OVER)

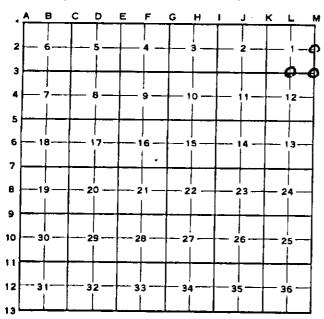

Apply letter prefix for corner points encircled above for identifying corner recordation numbers over.

FOR PROPERTY CONTROLLING AND MISC. PROPERTY CORNERS WITHIN THE SECTION (MENTIONED OVER AND EXCLUDE LOT CORNER)

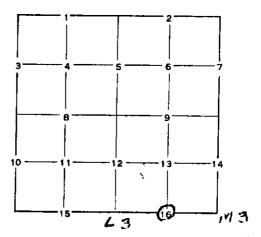

- 1. Above coded numbers are positioned on 1/16. fractional lines of the section.
- 2. Township corner code numbers shall be applied to corners of above typical section not numbered.
- 3. Miscellaneous property corners within a section, located at points other than numbered above, shall be referenced to at least two of above corner code numbers.
- 4. Private claim corners to be tied to rectangular land corners if possible sketch required below.

