

LAND CORNER RECORDATION CERTIFICATE

FILING REQUIREMENT OF ACT 74, MICH. P.A.1970

| FOR CORNERS OF--: | LOCATED IN--: | CORNER CODE NUMBER |
|---|-------------------------------------|--------------------|
| 1. PUBLIC LAND SURVEY _____ | T. 48 N. X , R. 33 K. W. | K4 |
| 2. PROPERTY CONTROLLING IN SECTION 12 _____ | T. 48 N. X , R. 33 K. W. | 3, 5 |
| 3. MISCELLANEOUS PROPERTY IN SECTION _____ | T. _____ N. _____, R. _____ E. W. | |
| 4. LOT NO. _____, RECORDED PLAT _____ | | |
| 5. PRIVATE CLAIMS _____ | | |

REGISTER OF DEEDS STAMP AND FILING NUMBER

I, Keith L. Sackett do hereby certify that under requirements of P.A. 74, Michigan P.A. of 1970, the corner points mentioned in lines 1 and 2 above (identified with circles on index code diagram—over) were, in a field survey on See below 19____, established, re-established, monumented, re-monumented, recovered or restored as expressed below and in conformance with regulations and rules therefore as required in the current manual of survey instructions of the United States Department of the Interior, Bureau of Land Management or by a decree of a court of law. Furthermore, that the corner points mentioned in lines 3, 4 and 5 above were, in a field survey on _____ 19____, found, recovered, restored, established or re-established as expressed below and in conformance with the rules of the Michigan State Board of Registration for Land Surveyors or, by a Decree of a Court of law:

A. Description of original monument and accessories and/or subsequent restoration:

Corner K4: Original monument and accessories not found.
Found squared 9" balsam N50°E (Mag.) 10.5 ft. used as approximate corner.

Corner 3: Not set on original survey nor subsequently apparently.

Corner 5: Not set on original survey nor subsequently apparently.

B. Description of corner evidence found and/or method applied in restoring or re-establishing corner:

Corner K4: Re-established 8-7-75 on line between section corners.

Corner 3: Established 8-7-75 on line between section corner north ¼ corner south.

Corner 5: Established 9-2-75 on subdivision of Section 12.

C. Description of monument for corner and accessories established to perpetuate locating the position of the corner:

Corner K4: Set 1" I.D. x 24" iron pipe with 4" aluminum cap.
10" Y. Birch N49°E (Mag.) 30.3 ft. ¼S, NBT
8" Sugar S40°W (Mag.) 18.6 ft. ¼S, NBT
14" " S32°E (Mag.) 20.7 ft. ¼S, NBT

Corner 3: Set 1" I.D. x 24" iron pipe with 4" aluminum cap under a 14" Y. Birch placed on 4 sides.
20" Cedar N28°W (Mag.) 14.3 ft. 1/16S, BT
10" " N18°E (Mag.) 24.7 ft. 1/16S, BT

Corner 5: Set 1" x 36" iron pipe with 4" aluminum cap in pile of stones.
4" Squared Cedar N54°W (Mag.) 3.8 ft. 1/16S, BT
6" Maple S74°W (Mag.) 11.5 ft. 1/16S, BT
7" Balsam N47°E (Mag.) 7.9 ft. 1/16S, BT


SIGNED BY _____ DATE _____

SURVEYOR'S MICHIGAN REGISTRATION NO. _____ (SEAL)

FOR STATE AND UNITED STATES AGENCIES:

SIGNED BY _____ DATE _____

APPROVED AND SIGNED BY Keith L. Sackett DATE November 19, 1975
CHIEF OF SURVEY PARTY
MICHIGAN REGISTERED LAND SURVEYOR
 Keith L. Sackett
 Department of Natural Resources

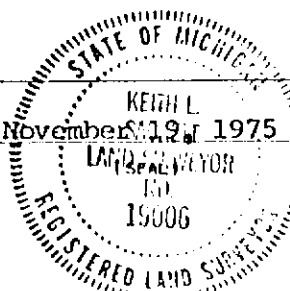

SURVEYOR'S MICHIGAN REGISTRATION NO. 19006


CORNER NUMBERING CODE DIAGRAMS FOR IDENTIFYING LAND CORNER RECORDATIONS AND INDEXING

FOR PUBLIC LAND SURVEY CORNERS IN THE
T. 48N, R. 33W (MENTIONED OVER)

| | A | B | C | D | E | F | G | H | I | J | K | L | M |
|----|---|----|----|----|----|----|----|---|---|---|---|---|---|
| 1 | | | | | | | | | | | | | |
| 2 | | 6 | 5 | 4 | 3 | 2 | 1 | | | | | | |
| 3 | | | | | | | | | | | | | |
| 4 | | 7 | 8 | 9 | 10 | 11 | 12 | | | | | | |
| 5 | | | | | | | | | | | | | |
| 6 | | 18 | 17 | 16 | 15 | 14 | 13 | | | | | | |
| 7 | | | | | | | | | | | | | |
| 8 | | 19 | 20 | 21 | 22 | 23 | 24 | | | | | | |
| 9 | | | | | | | | | | | | | |
| 10 | | 30 | 29 | 28 | 27 | 26 | 25 | | | | | | |
| 11 | | | | | | | | | | | | | |
| 12 | | 31 | 32 | 33 | 34 | 35 | 36 | | | | | | |
| 13 | | | | | | | | | | | | | |

Apply letter prefix for corner points encircled above for identifying corner recordation numbers over.

FOR PROPERTY CONTROLLING AND MISC. PROPERTY CORNERS WITHIN THE SECTION
(MENTIONED OVER AND EXCLUDE LOT CORNER)

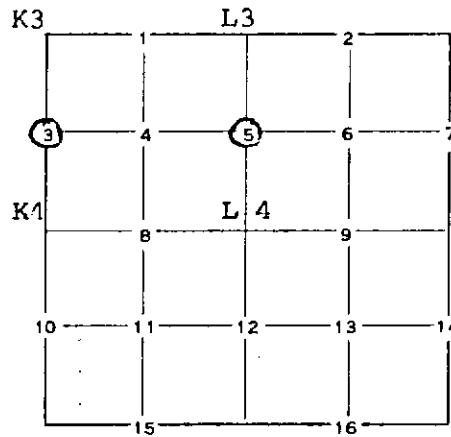

1. Above coded numbers are positioned on 1/16 fractional lines of the section.
2. Township corner code numbers shall be applied to corners of above typical section not numbered.
3. Miscellaneous property corners within a section, located at points other than numbered above, shall be referenced to at least two of above corner code numbers.
4. Private claim corners to be tied to rectangular land corners if possible - sketch required below.

EXPLANATORY SKETCH IF NECESSARY -- BELOW