

LAND CORNER RECORDATION CERTIFICATE
Filing Requirement of Act 74, Mich. P.A. 1970

For corners in

<u>Baraga</u> (County)	Located In:	Corner Code #	
1. Public Land Survey	T <u>48N</u> R <u>33W</u>	<u>811</u>	
	T _____ R _____	_____	
	T _____ R _____	_____	
	T _____ R _____	_____	
2. Property Controlling in Section	S _____ T _____ R _____	_____	
	S _____ T _____ R _____	_____	
3. Miscellaneous Property in Sec.	S _____ T _____ R _____	_____	
	S _____ T _____ R _____	_____	

Register of Deeds Stamp & File Number

4. Lot No. _____, Recorded Plat _____
 5. Private Claims _____

Feb 13 2002

I, Stephan J. Szyszkoski, in a field survey on _____, 20__ do hereby state that under requirements of P.A. 74, Michigan P.A. of 1970, the corner points mentioned in lines 1 and 2 above were in conformance with regulations and rules therefore as required in the current manual of survey instructions of the United States Department of the Interior, Bureau of Land Management or by a decree of a Court of Law and /or that the corner points mentioned in lines 3, 4 and 5 above were in conformance with the rules of the Michigan Board of Land Surveyors or by a Decree of a Court of Law; established, re-established, monumented, recovered, found as expressed below:


NOTE: Not more than 2 corners, all in the same town and range, may be recorded on this certificate.

	A	B	C	D	E	F	G	H	I	J	K	L	M
1													
2	6		5		4		3		2		1		
3													
4	7		8		9		10		11		12		
5													
6	18		17		16		15		14		13		
7													
8	19		20		21		22		23		24		
9													
10	30		29		28		27		26		25		
11	●												
12	31		32		33		34		35		36		
13													

A. Description of original monument and accessories and/or subsequent restoration:
 (811) Quarter corner common to Sections 30-31. Reestablished in 1987 by K.L. Sackett, RLS, by proportionate measurement. 1"IDx36" iron pipe with plastic cap. 7" Sugar S38W 19.4', 6" Y.Birch N48W 6.1', 6" Sugar S45E 27.7'.

B. Description of corner evidence found and/or method applied in restoring or reestablishing corner:
 (811) Found the 1987 monument at record bearing and distance from the 1987 witnesses. This monument does not occupy the intended position due to a 1987 error in calculation. I removed the 1987 monument and placed a new monument at the proportionate position, being on a line of mean true bearing between Section corners 2442.99' west and 2636.08' east.

C. Description of monument for corner and accessories established to perpetuate locating the position of the corner:
 (811) Set 1"IDx32" I.pipe with 4" alum. MDNR cap. Blazed and scribed:
 8" Spruce N20E 19.2' "1/4S NBT"
 the 1987 wits remeasured:
 8" Y.Birch N41W 14.4' do
 8" Sugar S46E 19.4' blazes overgrown
 10" Sugar S66W 19.6' do
 Placed a sq'd B.spruce post adjacent.
 Bearings are magnetic. Distances are to notch in lower blaze.

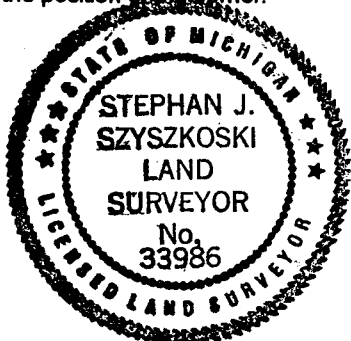

Signed by Stephan J. Szyszkoski
 Surveyor's Michigan License No. 33986

Date 4/18/02