

LAND CORNER RECORDATION CERTIFICATE
Filing Requirement of Act 74, Mich. P.A. 1970 as Amended

For corners in

<u>Baraga</u> <small>(County)</small>	Located in:	Corner Code #
1. Public Land Survey	T <u>48N</u> R <u>33W</u>	<u>K6</u>
	T <u>48N</u> R <u>33W</u>	<u>M8</u>
	T _____ R _____	_____
	S _____ T _____ R _____	_____
2. Property Controlling in Section	S _____ T _____ R _____	_____
	S _____ T _____ R _____	_____
3. Miscellaneous Property in Sec.	S _____ T _____ R _____	_____
	S _____ T _____ R _____	_____

Register of Deeds Stamp & File Number

4. Lot No. _____, Recorded Plat _____
 5. Private Claims

M8 Nov 04 2003
 K6 Oct 22 2003

I, Stephan J. Szyszkoski, in a field survey on _____, 20____ do hereby state that under requirements of P.A. 74, Michigan P.A. of 1970, the corner points mentioned in lines 1 and 2 above were in conformance with regulations and rules therefore as required in the current manual of survey instructions of the United States Department of the Interior, Bureau of Land Management or by a decree of a Court of Law and /or that the corner points mentioned in lines 3, 4 and 5 above were in conformance with the rules of the Michigan Board of Land Surveyors or by a Decree of a Court of Law; established, re-established, monumented, recovered, found as expressed below:

A	B	C	D	E	F	G	H	I	J	K	L	M
1												
2	6	5	4	3	2	1						
3												
4	7	8	9	10	11	12						
5												
6	18	17	16	15	14	13						
7												
8	19	20	21	22	23	24						
9												
10	30	29	28	27	26	25						
11												
12	31	32	33	34	35	36						
13												

NOTE: Not more than 2 corners, all in the same town and range, may be recorded on this certificate.

A. Description of original monument and accessories and/or subsequent restoration:


(K6) Quarter corner common to Sections 13-14. 1852: Established by Francis Houck, D.S.: South corrected between Secs. 13 & 14...40.00 Gr. post. Y. Birch 8 N62W 25 links, Y. Birch 16 S50E 37 links.
 (M8) Quarter corner common to Sections 24 T48N-R33W and 19 T48N-R32W. 1846: Established by Austin Burt, DS: North on east side of Section 24...40.00 Set Spruce post qr. Section corner. Spruce 8 S69 1/2E 22 links, Tamarac 10 N84W 44 links.

B. Description of corner evidence found and/or method applied in restoring or reestablishing corner:

(K6) Remonumented the corner at record bearing and distance from the two 1852 bearing trees, recovered in poor condition. Old blazes and axe marks are evident but no scribing was found. The original post was not recovered, the soil being very shallow and rocky. Distances north and south to adjacent section corners were found to be 2642.17' and 2635.23', respectively, K6 as remonumented being 1.28' East of a straight line between them.
 (M8) The original post and accessories were not recovered. Found no acceptable evidence of the position of the original corner on the ground. Reestablished the corner by single proportionate measurement to the original record between Section corner 2623.20' South and Quarter corner 5246.40' North.

C. Description of monument for corner and accessories established to perpetuate locating the position of the corner:

(K6) Set 1"IDx32" I.pipe with 4" alum. MDNR cap. Blazed, scribed, and set measuring nails in: 6" B.Spruce N83E 16.8' "1/4S N8T" 9" W.Spruce S10W 28.0' do 9" Cedar S45W 37.5' do 7" W.Spruce N28W 16.3' do	(M8) Set 1"IDx32" I.pipe with 4" alum. MDNR cap. Blazed, scribed, and set measuring nails in: 3" B.Spruce East 15.5' "1/4S N8T" 4" Tamarack S36E 16.5' do 3" Tamarack S60W 12.2' do 3" Tamarack N82W 13.5' do
Bearings are magnetic. Distances are to nail with tag.	Set squared spruce post adjacent. Bearings are magnetic. Distances are to nail with tag.

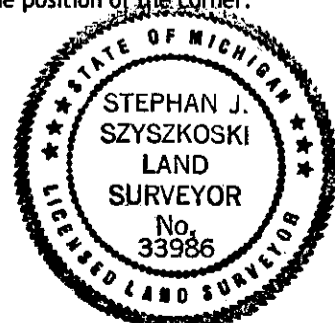

Signed by Stephan J. Szyszkoski
 Surveyor's Michigan License No. 33986

Date 11/13/03