

LAND CORNER RECORDATION CERTIFICATE
Filing Requirement of Act 74, Mich. P.A. 1970 as Amended

For corners in

Baraga
 (County)

Located In:

Corner Code #

- | | | |
|------------------------------------|---------------------------|-----------|
| 1. Public Land Survey | T <u>48N</u> R <u>33W</u> | <u>H9</u> |
| | T _____ R _____ | _____ |
| | T _____ R _____ | _____ |
| 2. Property Controlling in Section | S _____ T _____ R _____ | _____ |
| | S _____ T _____ R _____ | _____ |
| 3. Miscellaneous Property in Sec. | S _____ T _____ R _____ | _____ |
| | S _____ T _____ R _____ | _____ |

Register of Deeds Stamp & File Number

4. Lot No. _____, Recorded Plat _____
 5. Private Claims _____

May 25 2005

I, Stephan J. Szyszkoski, in a field survey on _____, 20____ do hereby state that under requirements of P.A. 74, Michigan P.A. of 1970, the corner points mentioned in lines 1 and 2 above were in conformance with regulations and rules therefore as required in the current manual of survey instructions of the United States Department of the Interior, Bureau of Land Management or by a decree of a Court of Law and /or that the corner points mentioned in lines 3, 4 and 5 above were in conformance with the rules of the Michigan Board of Land Surveyors or by a Decree of a Court of Law; established, re-established, monumented, recovered, found as expressed below:

NOTE: Not more than 2 corners, all in the same town and range, may be recorded on this certificate.

1	A	B	C	D	E	F	G	H	I	J	K	L	M
2		6		5		4		3		2		1	
3													
4		7		8		9		10		11		12	
5													
6		18		17		16		15		14		13	
7													
8		19		20		21		22		23		24	
9													
10		30		29		28		27		26		25	
11													
12		31		32		33		34		35		36	
13													

A. Description of original monument and accessories and/or subsequent restoration:


(H9) Quarter corner common to Sections 22 and 27. 1851 - Established by Francis Houck: S89 deg. 58'W corrected between Sections 22 & 27 ...40.05 Qr. post. Fir 8 N64W 18 links, Sugar 10 S65E 10 links. ...80.10 Section corner.

B. Description of corner evidence found and/or method applied in restoring or reestablishing corner:

(H9) The original post and accessories were not recovered. Reestablished the corner by single proportionate measurement to the original record between Section corners 2634.64' East and West. A Mead Corp. location poster dated 1-7-03 and marked "approx. GPS N38W 30'" was found attached to a 6" Maple N24E 18.3' distant.

C. Description of monument for corner and accessories established to perpetuate locating the position of the corner:

(H9) Set 1"IDx32" I.pipe with 4" alum. MDNR cap. Set measuring nails in:
 6" Maple N24E 18.3' mrkd "1/4S NBT"
 9" Spruce S47E 9.2' do
 10" Maple S53W 33.7' do
 12" Oak N45W 20.9' do
 Set sq'd cedar post adjacent. Bearings are magnetic. Distances are to nail with tag.

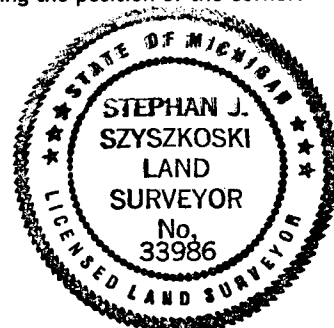

Signed by Stephan J. Szyszkoski
 Surveyor's Michigan License No. 33986

Date 7/27/05

For the Michigan Department of Natural Resources, Office of Land and Facilities