

LAND CORNER RECORDATION CERTIFICATE
Filing Requirement of Act 74, Mich. P.A. 1970 as Amended

For corners in

<u>Baraga</u> (County)	Located In:	Corner Code #
1. Public Land Survey	T <u>48N</u> R <u>33W</u>	<u>H10</u>
	T <u>48N</u> R <u>33W</u>	<u>L8</u>
	T _____ R _____	_____
	S _____ T _____ R _____	_____
2. Property Controlling in Section	S _____ T _____ R _____	_____
	S _____ T _____ R _____	_____
3. Miscellaneous Property in Sec.	S _____ T _____ R _____	_____
	S _____ T _____ R _____	_____

Register of Deeds Stamp & File Number

4. Lot No. _____, Recorded Plat _____
 5. Private Claims _____

Jul 12 2005

I, Stephan J. Szyszkoski, in a field survey on _____, 20____ do hereby state that under requirements of P.A. 74, Michigan P.A. of 1970, the corner points mentioned in lines 1 and 2 above were in conformance with regulations and rules therefore as required in the current manual of survey instructions of the United States Department of the Interior, Bureau of Land Management or by a decree of a Court of Law and /or that the corner points mentioned in lines 3, 4 and 5 above were in conformance with the rules of the Michigan Board of Land Surveyors or by a Decree of a Court of Law; established, re-established, monumented, recovered, found as expressed below:

NOTE: Not more than 2 corners, all in the same town and range, may be recorded on this certificate.

A. Description of original monument and accessories and/or subsequent restoration:

- (H10) Center of Section 27. Not established in the original survey.
- (L8) Center of Section 24. Not established in the original survey.


B. Description of corner evidence found and/or method applied in restoring or reestablishing corner:

- (H10) Established the corner at the intersection of a straight line between the North and South 1/4 corners of Section 27 with the mean-bearing E-W 1/4 line of Section 27. The E-W 1/4 line bearing is the mean of the bearings of the North and South lines of the Section.
- (L8) Established the corner at the intersection of straight lines connecting opposite 1/4 corners.

C. Description of monument for corner and accessories established to perpetuate locating the position of the corner:

- | | |
|--|--|
| (H10) Set 1"IDx32" I.pipe with 4" alum. MDNR cap in 3' dia. x 2' high mound of rock. Set measuring nails in: | (L8) Set 1"IDx32" I.pipe with 4" alum. MDNR cap. Set measuring nails in: |
| 8" W.Spruce S57E 19.5' mrkd "C1/4 BT" | 8" Maple N33E 7.6' mrkd "C1/4 BT" |
| 5" Maple in clump S14E 13.2' do | 13" Y.Birch S15E 22.2' do |
| 12" W.Spruce S43W 23.8' do | 13" Maple S85W 12.3' do |
| 4" Maple N19W 24.4' do | 8" double Maple N45W 25.0' do |
| Set sq'd Cedar post adjacent. Bearings are magnetic. Distances are to nail with tag. | Set sq'd Cedar post adjacent. Bearings are magnetic. Distances are to nail with tag. Made the mon. firm in a 3'dia.x 1.5' high rock mound. |

	A	B	C	D	E	F	G	H	I	J	K	L	M
1													
2	6		5		4		3		2		1		
3													
4	7		8		9		10		11		12		
5													
6	18		17		16		15		14		13		
7													
8	19		20		21		22		23		24		
9													
10	30		29		28		27		26		25		
11													
12	31		32		33		34		35		36		
13													

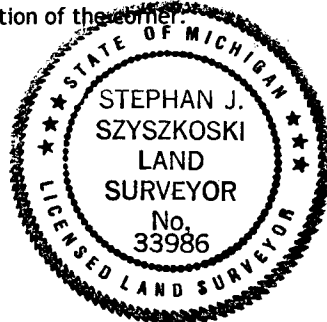

Signed by Stephan J. Szyszkoski
 Surveyor's Michigan License No. 33986

Date 7/27/05