LAND CORNER RECORDATION CERTIFICATE
Filing Requirement of Act 74, Mich. P.A. 1970 as Amended

For corners in

Baraga
(County)

		Located In:		Corner Code #
1. Public Land Survey		T 48N	R 33W	I2
		T	R	
		T	R	
	S	T	R	
2. Property Controlling	S 2	T 48N	R 33W	7
in Section	S	T	R	
3. Miscellaneous	S	T	R	
Property in Sec.	S	T	R	

Register of Deeds Stamp & File Number

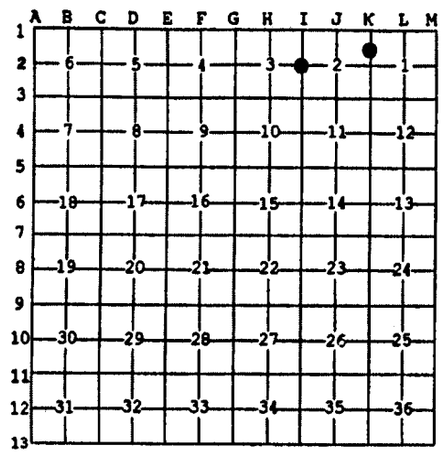

4. Lot No. _____ , Recorded Plat_____

5. Private Claims

7 Oct 25 2005
I2 Sep 22 2005

I, Stephan J. Szyszkoski, in a field survey on _____, 20 ____ do hereby state that under requirements of P.A. 74, Michigan P.A. of 1970, the corner points mentioned in lines 1 and 2 above were in conformance with regulations and rules therefore as required in the current manual of survey instructions of the United States Department of the Interior, Bureau of Land Management or by a decree of a Court of Law and /or that the corner points mentioned in lines 3, 4 and 5 above were in conformance with the rules of the Michigan Board of Land Surveyors or by a Decree of a Court of Law; established, re-established, monumented, recovered, found as expressed below:

NOTE: Not more than 2 corners, all in the same town and range, may be recorded on this certificate.

A. Description of original monument and accessories and/or subsequent restoration:

(I2) Quarter corner common to Sections 2 and 3. 1852 - Established by Francis Houck, Deputy Surveyor: " S4'W Corrected between Sections 2 & 3 ...37.57 Qr. post. Fir 8 N38E 6 links, Spruce 8 S60W 11 links. ...77.57 Corner of Sections 2-3-10-11". 1976 - Reestablished by K.L.Sackett RLS: Original monument and accessories not found. Reestablished 5-20-76 on line between section corners north and south. Set 1"IDx36" iron pipe with 4" aluminum cap. 4" Maple N84W 5.7', 10" W.Birch N42E 20.2', Squared 3" Cherry N9E 1.6'.
(7-Sec. 2) North 1/16 corner between Sections 1 and 2. 1975 - Established by K.L.Sackett RLS on line between section corner north and 1/4 corner south. Set 1"IDx36" iron pipe with 4" aluminum cap. 9" Sugar S24W 11.6', 9" Sugar S27E 21.1'.

B. Description of corner evidence found and/or method applied in restoring or reestablishing corner:

(I2) Found the 1976 monument in good condition and at record bearing and distance from the Maple NBT N84W which was subsequently cut down to facilitate GPS observations. Also found the W.Birch NBT at record bearing and distance. Verified the proportionate position by measuring to I1 2482.3' north and calculating the distance south to I3 of 2639 ft. by extrapolating from adjacent corners. Accepted the monument as a careful and faithful reestablishment of the position of the original corner.
(7-Sec. 2) Recovered the 1975 monument in good condition and at record bearing and distance from the 1975 witnesses, both in good condition with scribing visible. Determined the monument to be 0.87' north and 0.22' west of the proportionate position of record between Section corner 1151.95' north (GLO 17.50 ch.) and Quarter corner 1318.39' south (GO 20.00 ch.) and accepted same as a careful and faithful establishment of the position of the corner.

C. Description of monument for corner and accessories established to perpetuate locating the position of the corner:

(I2) Found 1"ID I.pipe with 4" alum. MDNR cap. Set measuring nails in:
10" W.Birch N46E 20.7' marks visible *
4" Sugar S22E 24.1' mrkd "1/4S NBT"
5" Sugar N86W 13.7' do
9" W.Pine N28W 26.3' do
Set sq'd cedar post adjacent. Bearings are magnetic. Distances are to nail with tag. * denotes 1976 NBT.

(7) Found 1"ID I.pipe with 4" alum. MDNR cap. Set measuring nails in:
11" Sugar S24E 21.7' old marks *
10" dbl Sugar S24W 11.9' do *
10" W.Spruce N51E 12.7' mrkd "1/16S BT"
7" dbl Maple N19W 17.8' do
Cedar 4x4 post adjacent. Bearings are magnetic. Distances are to nail with tag. * denotes 1975 NBT.

STATE OF MICHIGAN
STEPHAN J. SZYSZKOSKI
LAND SURVEYOR
No. 33986
LICENSED LAND SURVEYOR

Signed by Stephan J. Szyszkoski Date 2/29/06

Surveyor's Michigan License No. 33986

For the Michigan Department of Natural Resources, Office of Land and Facilities

FORM APPROVED BY MICHIGAN STATE BOARD OF PROFESSIONAL SURVEYORS, JAN. 28, 1971
Revised May 14, 1975
Revised Jan., 1983
Revised Oct., 1995