LAND CORNER RECORDATION CERTIFICATE
Filing Requirement of Act 74, Mich. P.A. 1970 as Amended

For corners in

Baraga (County)

		Located In:		Corner Code #
1. Public Land Survey		T 48N	R 33W	K1
		T	R	
		T	R	
	S	T	R	
2. Property Controlling	S 2	T 48N	R 33W	10
in Section	S	T	R	
3. Miscellaneous	S	T	R	
Property in Sec.	S	T	R	

Register of Deeds Stamp & File Number

4. Lot No. _____ , Recorded Plat_____

5. Private Claims

10 Sep 22 2005
K1 Sep 19 2005

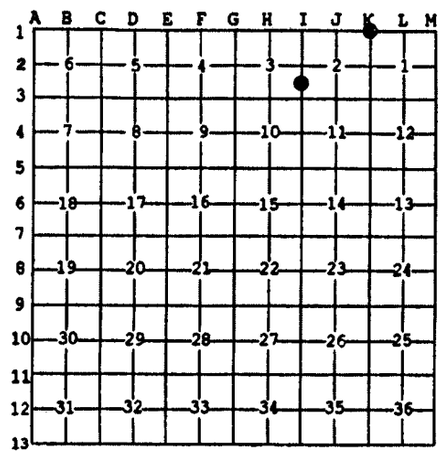

I, Stephan J. Szyszkoski, in a field survey on _____, 20 ____ do hereby state that under requirements of P.A. 74, Michigan P.A. of 1970, the corner points mentioned in lines 1 and 2 above were in conformance with regulations and rules therefore as required in the current manual of survey instructions of the United States Department of the Interior, Bureau of Land Management or by a decree of a Court of Law and /or that the corner points mentioned in lines 3, 4 and 5 above were in conformance with the rules of the Michigan Board of Land Surveyors or by a Decree of a Court of Law; established, re-established, monumented, recovered, found as expressed below:

NOTE: Not more than 2 corners, all in the same town and range, may be recorded on this certificate.

A. Description of original monument and accessories and/or subsequent restoration:

(K1) Corner common to Sections 1-2 T48N-R33W and Sections 35-36 T49N-R33W. 1846 - Established by Austin Burt, Deputy Surveyor: "West on South side of Section 36 ...80.00 Set Maple post corner of Sections 35 and 36. Sugar 12 N12 1/2E 26 links, Sugar 10 N51W 58 links.". 1852 - Additional BTs by Francis Houck, Deputy Surveyor: Sugar 8 S17W 46 links, Sugar 16 S20E 37 links. ca. July 1941 - Notes of N.T.Thompson RLS found at Northern Hardwoods office in Bovine, MI state: "New BT Sug 5 S68E 10'3", Sug 5 N15E 15'4". " Examination of Mr. Thompson's notes suggest that this corner was reestablished at the proportionate distance between Section corner 1 mile west and Township corner 1 mile east. 1975 - K.L.Sackett RLS found 2.5" ID iron pipe. NBTs 7" Sugar N78E 8.8', 7" Sugar S41W 25.9', 14" Sugar N72W 36.8'.
(10-Sec. 2) South 1/16 corner between Sections 2-3. 1976 - Established by K.L.Sackett RLS on line between section corner south and 1/4 corner north. Set 1"IDx32" I.pipe with 4" aluminum cap. 14" Sugar S50E 7.8', 9" Spruce S69W 11.0'.

B. Description of corner evidence found and/or method applied in restoring or reestablishing corner:

(K1) Found a 2.5" ID iron pipe, set firm, at record bearing and distance from the 1975 NBTs, all in good condition with overgrown blazes. Measurements to adjacent section corners were found to be 5268.3' West and 5271.2' East. The pipe is 30.3' south of a straight line between them. I accept the pipe as a careful and faithful reestablishment of the position of the original corner and drive a 1"ID iron pipe with MDNR cap into it. Note that the 1975 record described the 2.5" pipe monument as having been replaced with a 1" pipe with 4" aluminum cap. No such monument was recovered.
(10-Sec. 2) Found the 1976 monument in good condition and at record bearing and distance from the 1976 witnesses, now both stumps. Scribing is visible on the Spruce NBT stump. Left the monument in place and made new witnesses to update the accessories.

C. Description of monument for corner and accessories established to perpetuate locating the position of the corner:

(K1) Found 2.5" ID iron pipe. Drove 1"IDx32" I.pipe with alum. MDNR cap into it. Set measuring nails in:
10" Sugar N83E 9.2' overgrown blazes *
10" Sugar S43W 26.1' do *
16" Sugar N68W 37.2' old blz w/marks *
5" Sugar S14E 20.2' mrkd "S1 NBT"
Bearings are magnetic. Distances are to nail with tag. * denotes 1975 NBT.

(10) Found 1"ID I.pipe with 4" alum. MDNR cap. Set measuring nails in:
6" Sugar N39W 10.5' mrkd "1/16S BT"
5" Sugar N59E 19.0' do
6" Sugar S62E 22.0' do
5" Sugar West 36.8' do
5.5' tall sq'd sugar stub N13E 5.7' to center. Bearings are magnetic. Distances are to nail with tag.

STATE OF MICHIGAN
STEPHAN J. SZYSZKOSKI
LAND SURVEYOR
No. 33986
LICENSED LAND SURVEYOR

Signed by Stephan J. Szyszkoski Date 2/29/06

Surveyor's Michigan License No. 33986

For the Michigan Department of Natural Resources, Office of Land and Facilities

FORM APPROVED BY MICHIGAN STATE BOARD OF PROFESSIONAL SURVEYORS, JAN. 28, 1971
Revised May 14, 1975
Revised Jan., 1983
Revised Oct., 1995