

LAND CORNER RECORDATION CERTIFICATE
Filing Requirement of Act 74, Mich. P.A. 1970 as Amended

For corners in

Baraga
 (County)

Located In: Corner Code #

- | | | |
|------------------------------------|---------------------------|-----------|
| 1. Public Land Survey | T <u>48N</u> R <u>33W</u> | <u>K9</u> |
| | T _____ R _____ | _____ |
| | T _____ R _____ | _____ |
| 2. Property Controlling in Section | S _____ T _____ R _____ | _____ |
| | S _____ T _____ R _____ | _____ |
| 3. Miscellaneous Property in Sec. | S _____ T _____ R _____ | _____ |
| | S _____ T _____ R _____ | _____ |

Register of Deeds Stamp & File Number

4. Lot No. _____, Recorded Plat _____
 5. Private Claims _____

Jun 06 2005

I, Stephan J. Szyszkoski, in a field survey on _____, 20____ do hereby state that under requirements of P.A. 74, Michigan P.A. of 1970, the corner points mentioned in lines 1 and 2 above were in conformance with regulations and rules therefore as required in the current manual of survey instructions of the United States Department of the Interior, Bureau of Land Management or by a decree of a Court of Law and /or that the corner points mentioned in lines 3, 4 and 5 above were in conformance with the rules of the Michigan Board of Land Surveyors or by a Decree of a Court of Law; established, re-established, monumented, recovered, found as expressed below:

| | A | B | C | D | E | F | G | H | I | J | K | L | M |
|----|----|----|----|----|----|----|---|---|---|---|---|---|---|
| 1 | | | | | | | | | | | | | |
| 2 | 6 | 5 | 4 | 3 | 2 | 1 | | | | | | | |
| 3 | | | | | | | | | | | | | |
| 4 | 7 | 8 | 9 | 10 | 11 | 12 | | | | | | | |
| 5 | | | | | | | | | | | | | |
| 6 | 18 | 17 | 16 | 15 | 14 | 13 | | | | | | | |
| 7 | | | | | | | | | | | | | |
| 8 | 19 | 20 | 21 | 22 | 23 | 24 | | | | | | | |
| 9 | | | | | | | | | | | | | |
| 10 | 30 | 29 | 28 | 27 | 26 | 25 | | | | | | | |
| 11 | | | | | | | | | | | | | |
| 12 | 31 | 32 | 33 | 34 | 35 | 36 | | | | | | | |
| 13 | | | | | | | | | | | | | |

NOTE: Not more than 2 corners, all in the same town and range, may be recorded on this certificate.

A. Description of original monument and accessories and/or subsequent restoration:


(K9) Corner common to Sections 23-24-25-26. 1851 - Established by Francis Houck, Deputy Surveyor: N9'W Corrected between Sections 25 and 26 ...79.90 Corner of Sections 23-24-25&26. Sugar 14 N52E 46 links, Sugar 18 S48W 20 links.

B. Description of corner evidence found and/or method applied in restoring or reestablishing corner:

(K9) The original post and accessories were not recovered. Reestablished the corner by double proportionate measurement to the original record between Quarter corner 2633.57' West (rec. 39.88 chains), Section corner 5263.26' North (rec. 79.90 chains), Section corner 5313.57' East (rec. 80.46 chains) and Quarter corner 7894.88' South (rec. 119.85 chains).

C. Description of monument for corner and accessories established to perpetuate locating the position of the corner:

(K9) Set 1"IDx32" I.pipe with 4" alum.
 MDNR cap. Set measuring nails in:
 11" Sugar N48E 21.0' mrkd "S24 NBT"
 10" Sugar S17E 4.8' "S25 NBT"
 7" Sugar S50W 14.7' "S26 NBT"
 5" Sugar N31W 3.4' "S23 NBT"
 Set sq'd cedar post adjacent. Bearings are magnetic. Distances are to nail with tag.

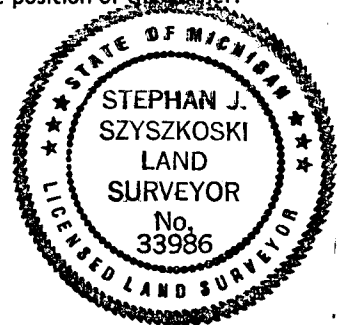

Signed by Stephan J. Szyszkoski
 Surveyor's Michigan License No. 33986

Date 7/27/05

For the Michigan Department of Natural Resources, Office of Land and Facilities