

**LAND CORNER RECORDATION CERTIFICATE**  
**Filing Requirement of Act 74, Mich. P.A. 1970 as Amended**

For corners in

Baraga

(County)

Located In:

Corner Code #

1. Public Land Survey

T 48N R 33W

K12

T \_\_\_\_\_ R \_\_\_\_\_

T \_\_\_\_\_ R \_\_\_\_\_

S \_\_\_\_\_ T \_\_\_\_\_ R \_\_\_\_\_

2. Property Controlling  
in Section

S \_\_\_\_\_ T \_\_\_\_\_ R \_\_\_\_\_

S \_\_\_\_\_ T \_\_\_\_\_ R \_\_\_\_\_

3. Miscellaneous  
Property in Sec.

S \_\_\_\_\_ T \_\_\_\_\_ R \_\_\_\_\_

S \_\_\_\_\_ T \_\_\_\_\_ R \_\_\_\_\_

Register of Deeds Stamp & File  
Number

4. Lot No. \_\_\_\_\_, Recorded Plat \_\_\_\_\_

5. Private Claims

May 24 2005

I, Stephan J. Szyszkoski, in a field survey on \_\_\_\_\_, 20\_\_\_\_ do hereby state that under requirements of P.A. 74, Michigan P.A. of 1970, the corner points mentioned in lines 1 and 2 above were in conformance with regulations and rules therefore as required in the current manual of survey instructions of the United States Department of the Interior, Bureau of Land Management or by a decree of a Court of Law and /or that the corner points mentioned in lines 3, 4 and 5 above were in conformance with the rules of the Michigan Board of Land Surveyors or by a Decree of a Court of Law; established, re-established, monumented, recovered, found as expressed below:

**NOTE: Not more than 2 corners, all in the same town and range, may be recorded on this certificate.**

A. Description of original monument and accessories and/or subsequent restoration:

(K12) Quarter corner common to Sections 35 and 36. 1851 - Established by Francis Houck, Deputy Surveyor: N9'W corrected between Sections 35 & 36 ...39.95 Set qr. post. Spruce 6 N70E 14 links, Tamarack 10 S44W 25 links. ... 79.90 Corner of Sections 25-26-35-36.


	A	B	C	D	E	F	G	H	I	J	K	L	M
1													
2		6		5		4		3		2		1	
3													
4		7		8		9		10		11		12	
5													
6		10		17		16		15		14		13	
7													
8		19		20		21		22		23		24	
9													
10		30		29		28		27		26		25	
11													
12		31		32		33		34		35		36	
13													

B. Description of corner evidence found and/or method applied in restoring or reestablishing corner:

(K12) The original post was not recovered. Remonumented the corner at substantial record bearing and record distance from the remains of two stumps, probably the original BTs: an 8" Spruce stump N60E (magnetic) 9.2' distant, solid below the water table, rotted above, with no markings visible, and a Tamarack stump S33W (magnetic) 16.5' distant, semi-solid below the water line, no markings visible. From the position thus established, I found an old post, laying down with point in place S31E 6.6' distant which does not appear old enough to be the original. True bearing and distance south to probable original corner is S 0 deg. 15'42"W 2642.50' (rec. as S09'E 39.95 chains). True bearing and distance north to an original corner at K7 is N0 deg. 02'55"W 13158.01 feet (rec. N9'W 199.75 chains=13183.5'), being 25.5' short of the GLO record.

C. Description of monument for corner and accessories established to perpetuate locating the position of the corner:

(K12) Set 1" IDx48" I.pipe with 4" alum. MDNR cap. Set measuring nails in:  
 4" B.Spruce S89E 28.6' mrkd "1/4S NBT"  
 3" B.Spruce S40E 24.3' do  
 5" Tamarack S17W 34.2' do  
 3" B.Spruce N45W 33.9' do  
 Set sq'd spruce post adjacent. Bearings are magnetic. Distances are to nail with tag.

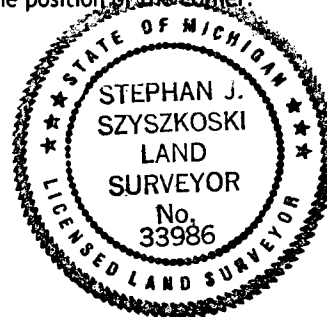

Signed by Stephan J. Szyszkoski  
 Surveyor's Michigan License No. 33986

Date 7/27/05

For the Michigan Department of Natural Resources, Office of Land and Facilities