

**LAND CORNER RECORDATION CERTIFICATE**  
**Filing Requirement of Act 74, Mich. P.A. 1970 as Amended**

For corners in

Baraga

(County)

Located In:

Corner Code #

- |                                    |                         |       |
|------------------------------------|-------------------------|-------|
| 1. Public Land Survey              | T 48N R 33W             | L11   |
|                                    | T _____ R _____         | _____ |
|                                    | T _____ R _____         | _____ |
| 2. Property Controlling in Section | S _____ T _____ R _____ | _____ |
|                                    | S _____ T _____ R _____ | _____ |
| 3. Miscellaneous Property in Sec.  | S _____ T _____ R _____ | _____ |
|                                    | S _____ T _____ R _____ | _____ |

Register of Deeds Stamp & File Number

4. Lot No. \_\_\_\_\_, Recorded Plat \_\_\_\_\_  
 5. Private Claims

May 26 2005

I, Stephan J. Szyszkoski, in a field survey on \_\_\_\_\_, 20\_\_\_\_ do hereby state that under requirements of P.A. 74, Michigan P.A. of 1970, the corner points mentioned in lines 1 and 2 above were in conformance with regulations and rules therefore as required in the current manual of survey instructions of the United States Department of the Interior, Bureau of Land Management or by a decree of a Court of Law and /or that the corner points mentioned in lines 3, 4 and 5 above were in conformance with the rules of the Michigan Board of Land Surveyors or by a Decree of a Court of Law; established, re-established, monumented, recovered, found as expressed below:

**NOTE: Not more than 2 corners, all in the same town and range, may be recorded on this certificate.**

	A	B	C	D	E	F	G	H	I	J	K	L	M
1													
2	6		5		4		3		2		1		
3													
4	7		8		9		10		11		12		
5													
6	18		17		16		15		14		13		
7													
8	19		20		21		22		23		24		
9													
10	30		29		28		27		26		25		
11													
12	31		32		33		34		35		36		
13													

A. Description of original monument and accessories and/or subsequent restoration:


(L11) Quarter corner common to Sections 25 and 36. 1851 - Established by Francis Houck: N89 deg. 56'W Corrected between Sections 25 & 36 ...40.025 Set qr. post. Tamarack 6 N53W 65 links, Tamarack 10 S48E 22 links. ...80.05 Section corner.

B. Description of corner evidence found and/or method applied in restoring or reestablishing corner:

(L11) The original post and accessories were not recovered. Reestablished the corner by single proportionate measurement to the original record between Section corners 2633.40' east and west.

C. Description of monument for corner and accessories established to perpetuate locating the position of the corner:

(L11) Set 1"IDx54" I.pipe with 4" alum.  
 MDNR cap. Set measuring nails in:  
 13" Tamarack N68E 10.1' mrkd "1/4S NBT"  
 8" twin B.Spruce N30E 10.3' do  
 7" Tamarack S01W 19.3' do  
 13" Tamarack S80W 16.2' do  
 Set sq'd tamarack post adjacent.  
 Bearings are magnetic. Distances are to nail with tag.

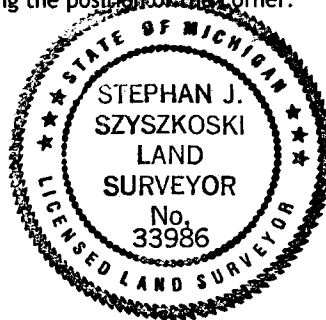

Signed by Stephan J. Szyszkoski  
 Surveyor's Michigan License No. 33986

Date 7/27/05

For the Michigan Department of Natural Resources, Office of Land and Facilities