

LAND CORNER RECORDATION CERTIFICATE
Filing Requirement of Act 74, Mich. P.A. 1970 as Amended

For corners in

<u>Baraga</u> (County)	Located In:	Corner Code #
1. Public Land Survey	T <u>48N</u> R <u>33W</u>	<u>M1</u>
	T _____ R _____	_____
	T _____ R _____	_____
2. Property Controlling in Section	S _____ T <u>48N</u> R <u>33W</u>	<u>2</u>
	S _____ T _____ R _____	_____
3. Miscellaneous Property in Sec.	S _____ T _____ R _____	_____
	S _____ T _____ R _____	_____

Register of Deeds Stamp & File Number

4. Lot No. _____, Recorded Plat _____
 5. Private Claims

M1 Nov 22 2005
 2 Oct 27 2005

1	A	B	C	D	E	F	G	H	I	J	K	L	M
2		6		5		4		3		2		1	
3													
4		7		8		9		10		11		12	
5													
6		18		17		16		15		14		13	
7													
8		19		20		21		22		23		24	
9													
10		30		29		28		27		26		25	
11													
12		31		32		33		34		35		36	
13													

I, Stephan J. Szyszkoski, in a field survey on _____, 20____ do hereby state that under requirements of P.A. 74, Michigan P.A. of 1970, the corner points mentioned in lines 1 and 2 above were in conformance with regulations and rules therefore as required in the current manual of survey instructions of the United States Department of the Interior, Bureau of Land Management or by a decree of a Court of Law and /or that the corner points mentioned in lines 3, 4 and 5 above were in conformance with the rules of the Michigan Board of Land Surveyors or by a Decree of a Court of Law; established, re-established, monumented, recovered, found as expressed below:

NOTE: Not more than 2 corners, all in the same town and range, may be recorded on this certificate.

A. Description of original monument and accessories and/or subsequent restoration:

(M1) Corner common to T48-49N R32-33W. 1846 - Established by Austin Burt, Deputy Surveyor: "West on South side of Section 36 T49N-R33W. Set post corner of T's 48 & 49N R's 32 & 33W. Fir 10 S65E 24 links, Cedar 10 N57W 24 links". 1957 - Billy D. Buckler RLS records that he "Set corner at intersection of blazed lines. Found numerous blazes and cruisers names at corner location. Found no absolute evidence of original B.T.s. Found 15" Cedar S40W 43 links...scribed. This tree appears to be as old as the original survey. Could find no record of such tree". Set 1"ID pipe with 4" brass cap. 12" Cedar S52W 49 links, 12" W.Pine N18E 121 links. (2-Sec. 2) East 1/16 corner between Section 2 T48N-R33W and Section 35 T49N-R33W. Not established in the original survey.

B. Description of corner evidence found and/or method applied in restoring or reestablishing corner:


(M1) The 1957 monument was recovered in good condition and at record bearing and distance from the NBT W.Pine N18E 121 links. The NBT Cedar was not recovered. Distances west to monuments placed by N.T.Thompson RLS in the 1940's suggest that Mr. Thompson used this same position to reestablish section and quarter corners on the south lines of Sections 35 and 36 T49N-R33W. I accept the monument as the best available evidence of the position of the original corner.

(2-Sec. 2) Established the corner on the township line and midway between Quarter corner 1316.88' west and Section corner 1316.88' east.

C. Description of monument for corner and accessories established to perpetuate locating the position of the

(M1) Fd 1"ID I.pipe with 4" brass State of MI cap. Set measuring nails in:
 22" W.Pine N15E 78.5' old blazes *
 6" Cedar N67E 47.6' mrkd "S31 NBT"
 14" Cedar S25W 44.6' "S1 NBT"
 14" Cedar N57W 13.1' "S36 NBT"
 Set sq'd cedar post adjacent. Bearings are magnetic. Distances are to nail with tag. * denotes 1957 NBT.

(2) Set 1"IDx32" I.pipe with 4" alum. MDNR cap. Set measuring nails in:
 12" Sugar N46E 35.2' mrkd "1/16S BT"
 8" Sugar S55E 12.9' do
 11" Sugar S29W 17.7' do
 8" Sugar N42W 15.9' do
 Set sq'd cedar post adjacent. Bearings are magnetic. Distances are to nail with tag.

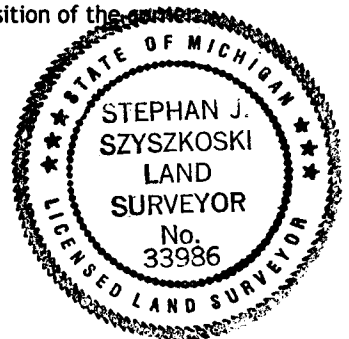

Signed by Stephan J. Szyszkoski
 Surveyor's Michigan License No. 33986

Date 2/29/06

For the Michigan Department of Natural Resources, Office of Land and Facilities