LAND CORNER RECORDATION CERTIFICATE
Filing Requirement of Act 74, Mich. P.A. 1970 as Amended

For corners in

Baraga
(County)

	Located In:	Corner Code #
1. Public Land Survey	T 48N R 33W	M11
	T___ R___	
	T___ R___	
	S___ T___ R___	
2. Property Controlling	S___ T___ R___	
in Section	S___ T___ R___	
3. Miscellaneous	S___ T___ R___	
Property in Sec.	S___ T___ R___	

Register of Deeds Stamp & File Number

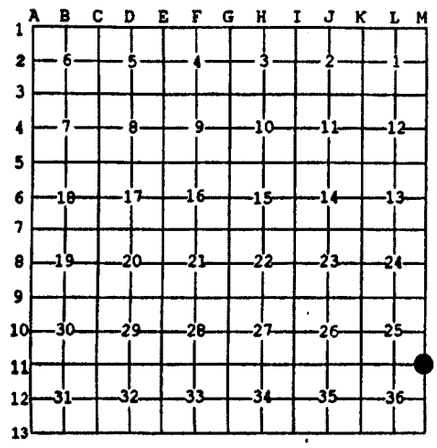

4. Lot No. _____ , Recorded Plat_____

5. Private Claims

Jun 02 2005

I, Stephan J. Szyszkoski, in a field survey on _____, 20 ____ do hereby state that under requirements of P.A. 74, Michigan P.A. of 1970, the corner points mentioned in lines 1 and 2 above were in conformance with regulations and rules therefore as required in the current manual of survey instructions of the United States Department of the Interior, Bureau of Land Management or by a decree of a Court of Law and /or that the corner points mentioned in lines 3, 4 and 5 above were in conformance with the rules of the Michigan Board of Land Surveyors or by a Decree of a Court of Law; established, re-established, monumented, recovered, found as expressed below:

NOTE: Not more than 2 corners, all in the same town and range, may be recorded on this certificate.

A. Description of original monument and accessories and/or subsequent restoration:

(M11) Corner common to Sections 25&36 T48N-R33W, and Sections 30&31 T48N-R32W. 1846 - Established by Austin Burt, Deputy Surveyor: North on East side of Sec. 36 ...80.00 Set Spruce post corner of Sections 25 & 36. Tamarack 7 S37W 10 links, Tamarack 6 N83 1/2E 44 links. 1851 - Additional BTs by Guy Carleton, Deputy Surveyor: Tamarack 6 S50E 10 links, Spruce 6 N77W 31 links.

B. Description of corner evidence found and/or method applied in restoring or reestablishing corner:

(M11) The original post and accessories were not recovered. Reestablished the corner by single proportionate measurement to the original record between Section corners 5277.25' north and south. The corner falls in a very wet swamp. Hip waders are needed.

C. Description of monument for corner and accessories established to perpetuate locating the position of the corner:

(M11) Set 1"IDx54" I.pipe with 4" alum.
MDNR cap made firm with wooden hubs.
Set measuring nails in:
10" B.Spruce S10W 52.6' mrkd "S36 NBT"
5" Tamarack N51W 81.8' "S25 NBT"
9" B.Spruce N19E 80.7' "S30 NBT"
4" B.Spruce N61E 73.3' do
Set sq'd cedar post adjacent. Bearings are magnetic. Distances are to nail with tag.

STATE OF MICHIGAN
STEPHAN J. SZYSZKOSKI
LAND SURVEYOR
No. 33986
LICENSED LAND SURVEYOR

Signed by Stephen J. Szyszkoski Date 7/27/05

Surveyor's Michigan License No. 33986

For the Michigan Department of Natural Resources, Office of Land and Facilities

FORM APPROVED BY MICHIGAN STATE BOARD OF PROFESSIONAL SURVEYORS, JAN. 28, 1971
Revised May 14, 1975
Revised Jan., 1983
Rervised Oct., 1995