LAND CORNER RECORDATION CERTIFICATE
Filing Requirement of Act 74, Mich. P.A. 1970 as Amended

For corners in

Baraga
(County)

		Located In:		Corner Code #
1. Public Land Survey		T 48N	R 33W	M12
		T	R	
		T	R	
	S	T	R	
2. Property Controlling	S	T	R	
in Section	S	T	R	
3. Miscellaneous	S	T	R	
Property in Sec.	S	T	R	

Register of Deeds Stamp & File Number

4. Lot No. _____ , Recorded Plat_____
5. Private Claims

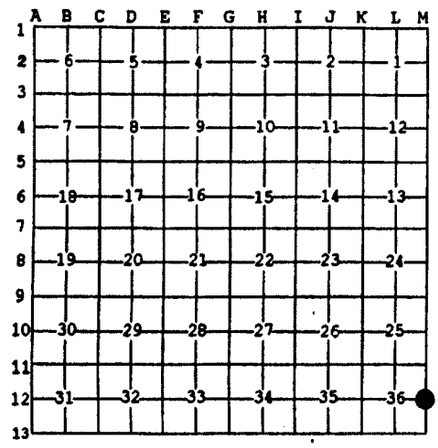

May 26 2005

I, Stephan J. Szyszkoski, in a field survey on _____, 20 ____ do hereby state that under requirements of P.A. 74, Michigan P.A. of 1970, the corner points mentioned in lines 1 and 2 above were in conformance with regulations and rules therefore as required in the current manual of survey instructions of the United States Department of the Interior, Bureau of Land Management or by a decree of a Court of Law and /or that the corner points mentioned in lines 3, 4 and 5 above were in conformance with the rules of the Michigan Board of Land Surveyors or by a Decree of a Court of Law; established, re-established, monumented, recovered, found as expressed below:

NOTE: Not more than 2 corners, all in the same town and range, may be recorded on this certificate.

A. Description of original monument and accessories and/or subsequent restoration:

(M12) Quarter corner common to Section 36 T48N-R33W and Section 31 T48N-R32W. 1846 - Established by Austin Burt, Deputy Surveyor: North on East side of Section 36 ...40.00 Set Spruce post qr. Section corner. Tamarack 10 S73W 51 links, Spruce 8 N7 1/2E 27 links. ...80.00 Section corner.

B. Description of corner evidence found and/or method applied in restoring or reestablishing corner:

(M12) The original post and accessories were not recovered. Reestablished the corner by single proportionate measurement to the original record between Section corners M13 2638.62' South and M9 7915.88' North. The Range line bears N00 deg. 05'05"E (true) between these two corners. The monument was driven into the rocky ground which is covered by standing water. The monument leans easterly but the top center of the cap marks the position for the corner.

C. Description of monument for corner and accessories established to perpetuate locating the position of the corner:

(M12) Set 1"IDx32" I.pipe with 4" alum.
MDNR cap. Set measuring nails in:
9" B.Spruce N23E 10.5' mrkd "1/4S NBT"
7" Cedar S81E 11.4' do
5" Tamarack S42W 20.8' do
8" Cedar N40W 29.8' do
Set sq'd cedar post adjacent. Bearings are magnetic. Distances are to nail with tag. The top center of the cap marks the corner position.

STATE OF MICHIGAN
STEPHAN J. SZYSZKOSKI
LAND SURVEYOR
No. 33986
LICENSED LAND SURVEYOR

Signed by Stephan J. Szyszkoski Date 7/27/05

Surveyor's Michigan License No. 33986

For the Michigan Department of Natural Resources, Office of Land and Facilities

FORM APPROVED BY MICHIGAN STATE BOARD OF PROFESSIONAL SURVEYORS, JAN. 28, 1971
Revised May 14, 1975
Revised Jan., 1983
Rervised Oct., 1995