LAND CORNER RECORDATION CERTIFICATE
Filing Requirement of Act 74, Mich. P.A. 1970 as Amended

For corners in

Baraga
(County)

	Located In:			Corner Code #
1. Public Land Survey		T____	R____	
		T____	R____	
		T____	R____	
	S____	T____	R____	
2. Property Controlling	S 27	T 48N	R 33W	9
in Section	S____	T____	R____	
3. Miscellaneous	S____	T____	R____	
Property in Sec.	S____	T____	R____	

Register of Deeds Stamp & File Number

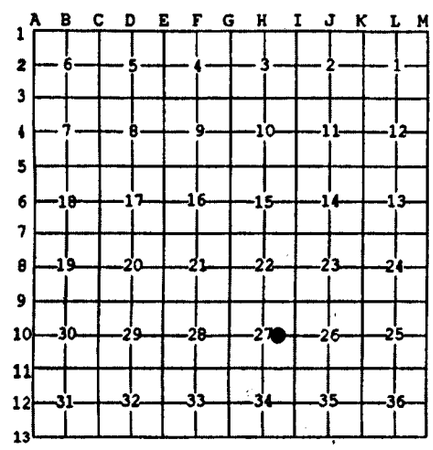

4. Lot No. _____ , Recorded Plat_____
5. Private Claims

Jul 11 2005

I, Stephan J. Szyszkoski, in a field survey on _____, 20 ____ do hereby state that under requirements of P.A. 74, Michigan P.A. of 1970, the corner points mentioned in lines 1 and 2 above were in conformance with regulations and rules therefore as required in the current manual of survey instructions of the United States Department of the Interior, Bureau of Land Management or by a decree of a Court of Law and /or that the corner points mentioned in lines 3, 4 and 5 above were in conformance with the rules of the Michigan Board of Land Surveyors or by a Decree of a Court of Law; established, re-established, monumented, recovered, found as expressed below:

NOTE: Not more than 2 corners, all in the same town and range, may be recorded on this certificate.

A. Description of original monument and accessories and/or subsequent restoration:

(9-Sec. 27) East 1/16 corner, Section 27. Not established in the original survey.

B. Description of corner evidence found and/or method applied in restoring or reestablishing corner:

(9-Sec. 27) Established the corner at the intersection of the mean-bearing E-W 1/4 line with the mean-bearing East N-S 1/16 line. The bearing of the 1/4 line is the mean of the bearings of the North and South lines of the Section. The bearing of the 1/16 line is the mean of the bearings of the N-S 1/4 line and the East line of Sec. 27.

C. Description of monument for corner and accessories established to perpetuate locating the position of the corner:

(9) Set 1"IDx60" I.pipe with 4" alum.
MDNR cap made firm with wooden hubs.
Set measuring nails in:
22" W.Pine N01E 32.6' mrkd "1/16S 8T"
11" Spruce S36E 1.65' do
4" Maple S60W 10.75' do
5" Maple N62W 35.9' do
Bearings are magnetic. Distances are to nail with tag.

STATE OF MICHIGAN
STEPHAN J. SZYSZKOSKI
LAND SURVEYOR
No. 33986
LICENSED LAND SURVEYOR

Signed by Stephan J. Szyszkoski Date 7/27/05

Surveyor's Michigan License No. 33986

For the Michigan Department of Natural Resources, Office of Land and Facilities

FORM APPROVED BY MICHIGAN STATE BOARD OF PROFESSIONAL SURVEYORS, JAN. 28, 1971
Revised May 14, 1975
Revised Jan., 1983
Revised Oct., 1995