LAND CORNER RECORDATION CERTIFICATE
Filing Requirement of Act 74, Mich. P.A. 1970 as Amended

For corners in

Baraga
(County)

	Located In:		Corner Code #
1. Public Land Survey		T____ R____	
		T____ R____	
		T____ R____	
	S____	T____ R____	
2. Property Controlling	S 25	T 48N R 33W	11
in Section	S 25	T 48N R 33W	5
3. Miscellaneous	S____	T____ R____	
Property in Sec.	S____	T____ R____	

Register of Deeds Stamp & File Number

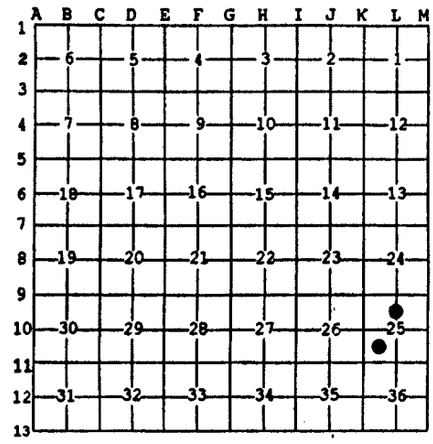

4. Lot No. _____ , Recorded Plat_____

5. Private Claims

I, Stephan J. Szyszkoski, in a field survey on _____, 20____ (Jun 06 2005) do hereby state that under requirements of P.A. 74, Michigan P.A. of 1970, the corner points mentioned in lines 1 and 2 above were in conformance with regulations and rules therefore as required in the current manual of survey instructions of the United States Department of the Interior, Bureau of Land Management or by a decree of a Court of Law and /or that the corner points mentioned in lines 3, 4 and 5 above were in conformance with the rules of the Michigan Board of Land Surveyors or by a Decree of a Court of Law; established, re-established, monumented, recovered, found as expressed below:

NOTE: Not more than 2 corners, all in the same town and range, may be recorded on this certificate.

A. Description of original monument and accessories and/or subsequent restoration:

(11-Sec. 25) Southwest 1/16 corner, Sec. 25. Not established in the original survey.
(5-Sec. 25) North 1/16 corner, Section 25. Not established in the original survey.

B. Description of corner evidence found and/or method applied in restoring or reestablishing corner:

(11-Sec. 25) Established the corner at the intersection of straight lines connecting opposite 1/16 corners.
(5-Sec. 25) Established the corner midway and on a straight line between Quarter corner 1317.47' north and Center of Section (not monumented) 1317.47' South.

C. Description of monument for corner and accessories established to perpetuate locating the position of the corner:

(11) Set 1"IDx60" I.pipe with 4" alum. MDNR cap. Set measuring nails in:
3" B.Spruce N22E 3.6' mrkd "1/16S BT"
5" B.Spruce S53E 14.5' do
5" B.Spruce S34W 12.3' do
5" B.Spruce S87W 13.3' do
Set sq'd Spruce post adjacent. Bearings are magnetic. Distances are to nail with tag.

(5) Set 1"IDx60" I.pipe with 4" alum. MDNR cap. Set measuring nails in:
4" B.Spruce N12E 6.8' mrkd "1/16S BT"
4" B.Spruce S73E 6.5' do
5" B.Spruce S13W 16.3' do
4" B.Spruce N78W 6.9' do
Set sq'd spruce post adjacent. Bearings are magnetic. Distances are to nail with tag.

STATE OF MICHIGAN
STEPHAN J. SZYSZKOSKI
LAND SURVEYOR
No. 33986
LICENSED LAND SURVEYOR

Signed by Stephan J. Szyszkoski Date 7/27/05

Surveyor's Michigan License No. 33986

For the Michigan Department of Natural Resources, Office of Land and Facilities

FORM APPROVED BY MICHIGAN STATE BOARD OF PROFESSIONAL SURVEYORS, JAN. 28, 1971
Revised May 14, 1975
Revised Jan., 1983
Rervised Oct., 1995