

LAND CORNER RECORDATION CERTIFICATE
Filing Requirement of Act 74, Mich. P.A. 1970 as Amended

For corners in

<u>Baraga</u> (County)	Located In:	Corner Code #
1. Public Land Survey	T <u>48N</u> R <u>33W</u>	MC #2 (Meander Corner on North shore of King Lake between Sections 26 and 27)
	T ___ R ___	
	T ___ R ___	
2. Property Controlling in Section	S ___ T ___ R ___	
	S ___ T ___ R ___	
3. Miscellaneous Property in Sec.	S ___ T ___ R ___	
	S ___ T ___ R ___	

Register of Deeds Stamp & File
Number

4. Lot No. _____, Recorded Plat _____
 5. Private Claims

I, Stephan J. Szyszkoski, in a field survey on June 21, 2005 do hereby state that under requirements of P.A. 74, Michigan P.A. of 1970, the corner points mentioned in lines 1 and 2 above were in conformance with regulations and rules therefore as required in the current manual of survey instructions of the United States Department of the Interior, Bureau of Land Management or by a decree of a Court of Law and /or that the corner points mentioned in lines 3, 4 and 5 above were in conformance with the rules of the Michigan Board of Land Surveyors or by a Decree of a Court of Law; established, re-established, monumented, recovered, found as expressed below:

NOTE: Not more than 2 corners, all in the same town and range, may be recorded on this certificate.

1	A	B	C	D	E	F	G	H	I	J	K	L	M
2		6		5		4		3		2		1	
3													
4		7		8		9		10		11		12	
5													
6		18		17		16		15		14		13	
7													
8		19		20		21		22		23		24	
9													
10		30		29		28		27		26		25	
11													
12		31		32		33		34		35		36	
13													

A. Description of original monument and accessories and/or subsequent restoration:


Meander corner on the north shore of King Lake, between Sections 26 and 27. 1851 - Established by Francis Houck (1850 instructions): North[11'W] Corrected between Sections 26 & 27 ...47.67 Over lake and set Meander Corner. Fir 8 N30°W 18 links, Fir N11°E 17 links. ... 80.00 Corner of Sections 22-23-26-27.
 Found no subsequent record.

B. Description of corner evidence found and/or method applied in restoring or reestablishing corner:

The original post and accessories were not recovered. Reestablished the corner on a line between reestablished Section corner I9 and perpetuated original Section corner I13 (corners I10, I11, and I12 falling in King Lake) at GLO record distance from I9, adjusted by an index correction of -9 ft. per 80 chains. Therefore, the corner was reestablished S 00°00'39"E (true), 2130.15' from Section corner I9. The index correction is based on the observation of 8 nearby Section lines. Rather than running in the direction of the Section line at the index-corrected record bearing of S 00°11'W, I reestablished it as described, thinking that to be the better method in this case, and conforming more closely with the original survey, given the long interval across the lake.

C. Description of monument for corner and accessories established to perpetuate locating the position of the corner:

Set 1"IDx32" I.pipe with 4" aluminum MDNR cap. Set measuring nails in:
 5" Balsam N66°E 7.5' mrkd "MC BT"
 6" Balsam S72°E 11.5' do
 14" W.Spruce S79°W 25.8' do
 5" W.Spruce N74°W 17.1' do
 Set sq'd Cedar post adjacent. Bearings are magnetic. Distances are to nail with tag.

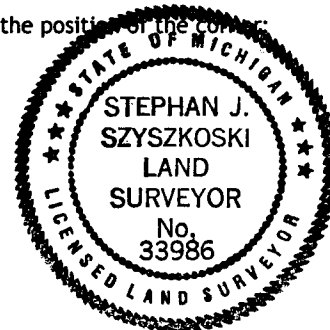

Signed by Stephan J. Szyszkoski
 Surveyor's Michigan License No. 33986

Date 7/27/05

For the Michigan Department of Natural Resources, Office of Land and Facilities