LAND CORNER RECORDATION CERTIFICATE
Filing Requirement of Act 74, Mich. P.A. 1970 as Amended

For corners in

Baraga (County)

		Located In:		Corner Code #
1. Public Land Survey		T 48N	R 34W	M1
		T 48N	R 34W	K1
		T	R	
	S	T	R	
2. Property Controlling	S	T	R	
in Section	S	T	R	
3. Miscellaneous	S	T	R	
Property in Sec.	S	T	R	

Register of Deeds Stamp & File Number

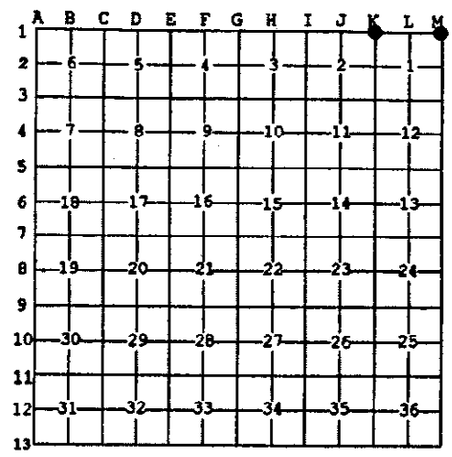

4. Lot No. _____ , Recorded Plat_____

5. Private Claims

K1 Jul 01 2004
M1 Jun 30 2004

I, Stephan J. Szyszkoski, in a field survey on _____, 20____ do hereby state that under requirements of P.A. 74, Michigan P.A. of 1970, the corner points mentioned in lines 1 and 2 above were in conformance with regulations and rules therefore as required in the current manual of survey instructions of the United States Department of the Interior, Bureau of Land Management or by a decree of a Court of Law and /or that the corner points mentioned in lines 3, 4 and 5 above were in conformance with the rules of the Michigan Board of Land Surveyors or by a Decree of a Court of Law; established, re-established, monumented, recovered, found as expressed below:

NOTE: Not more than 2 corners, all in the same town and range, may be recorded on this certificate.

A. Description of original monument and accessories and/or subsequent restoration:

(M1) Corner of Townships T48-49N, R33-34W. 1846 - Established by Austin Burt: Intersected Range Line 2.52 south of temporary corner and set post...Sugar 16 S60E 44, Sugar 12 N72W 42. Chainage south to M2 is 77.48 chains in the GLO record. Chainage to Sec. cor 1 mile east is 76.00 in the GLO record. Found old pencil-notation, date unknown, in MDNR transcription of GLO notes "Ok" adjacent to BT N72W. 1974 - K.L.Sackett RLS found iron pipe at corner.
(K1) Corner common to Sections 1-2 T48N-R34W and 35-36 T49N-R34W. 1846 - Established by Austin Burt: West on S. side Section 36 (T49N-R34W)...80.00 Set Sugar post corner of Secs 35&36. Sugar 10 N57E 32 links, Sugar 12 N17W 28 links. Additional BTs by Francis Colman 1853: Hemlock 24 S35E 32, Fir 10 S41W 10.

B. Description of corner evidence found and/or method applied in restoring or reestablishing corner:

(M1) Found and accepted an old 1"ID iron pipe with rotting sq'd cedar post, on the ground, adjacent. The original accessories were not recovered. Distance south to M2 was found to be 77.204 chains. Distance east to C1 T48N-R33W was found to be 75.608 chains. The easting of this monument is consistent with the GLO record with respect to recovered monumented section corners one, two, three, and four miles to the south.
(K1) The original post and accessories were not recovered, likely destroyed by logging and road building. Reestablished the corner on the township line by single proportionate measurement to the original GLO record between Section corner 15892.31' west and Township corner 5297.44' east.

C. Description of monument for corner and accessories established to perpetuate locating the position of the corner:

(M1) Found 1"ID I.pipe. Blazed, scribed, and set measuring nails in:

7" Sugar N72E 13.6'	"S31 NBT"
6" Sugar S44E 10.6'	"S6 NBT"
5" Sugar S17W 11.2'	"S1 NBT"
7" Sugar N69W 10.9'	"S36 NBT"

Bearings are magnetic. Distances are to nail with tag.

(K1) Set 1"IDx32" I.pipe with 4" alum. MDNR cap. Blazed, scribed, and set measuring nails in:

11" Y.Birch N43E 21.3'	"S36 NBT"
12" Sugar S23E 22.5'	"S1 NBT"
12" Y.Birch S67W 45.3'	"S2 NBT"
12" Sugar N29W 73.9'	"S35 NBT"

Set Sq'd cedar post adjacent. Bearings are magnetic. Distances are to nail with tag.

STATE OF MICHIGAN
STEPHAN J. SZYSZKOSKI
LAND SURVEYOR
No. 33986
LICENSED LAND SURVEYOR

Signed by Stephen J. Szyszkoski Date 8/30/04

Surveyor's Michigan License No. 33986

For the Michigan Department of Natural Resources, Office of Land and Facilities

FORM APPROVED BY MICHIGAN STATE BOARD OF PROFESSIONAL SURVEYORS, JAN. 28, 1971
Revised May 14, 1975
Revised Jan., 1983
Revised Oct., 1995