

LAND CORNER RECORDATION CERTIFICATE
Filing Requirement of Act 74, Mich. P.A. 1970 as Amended

For corners in

<u>Baraga</u> (County)	Located In:	Corner Code #
1. Public Land Survey	T <u>48N</u> R <u>34W</u>	<u>K3</u>
	T _____ R _____	_____
	T _____ R _____	_____
2. Property Controlling in Section	S _____ T <u>48N</u> R <u>34W</u>	<u>6</u>
	S _____ T _____ R _____	_____
3. Miscellaneous Property in Sec.	S _____ T _____ R _____	_____
	S _____ T _____ R _____	_____
4. Lot No. _____, Recorded Plat _____		
5. Private Claims		

Register of Deeds Stamp & File Number

A	B	C	D	E	F	G	H	I	J	K	L	M
1												
2	6	5	4	3	2							
3												
4	7	8	9	10	11	12						
5												
6	18	17	16	15	14	13						
7												
8	19	20	21	22	23	24						
9												
10	30	29	28	27	26	25						
11												
12	31	32	33	34	35	36						
13												

Jun 30 2004

I, Stephan J. Szyszkoski, in a field survey on _____, 20____ do hereby state that under requirements of P.A. 74, Michigan P.A. of 1970, the corner points mentioned in lines 1 and 2 above were in conformance with regulations and rules therefore as required in the current manual of survey instructions of the United States Department of the Interior, Bureau of Land Management or by a decree of a Court of Law and /or that the corner points mentioned in lines 3, 4 and 5 above were in conformance with the rules of the Michigan Board of Land Surveyors or by a Decree of a Court of Law; established, re-established, monumented, recovered, found as expressed below:

NOTE: Not more than 2 corners, all in the same town and range, may be recorded on this certificate.

A. Description of original monument and accessories and/or subsequent restoration:


(K3) Corner common to Sections 1-2-11-12. 1853 - Established by Francis Colman: [south] Corrected between 1&2 ...76.88 line leaves stream 30 C. N3E at right bank, 77.63 Set post cor. of Sections 1-2-11-12. [west] Corrected btwn 2&11, 0.40 Stream 50 links, C North ...80.17 Section corner. [west] Corrected between 1&12 ...80.56 Sec. corner. [south] Corrected between 11&12 ... 2.40 Stream 50 links, C NNW rapid. ...80.00 Section corner.
 (6-Sec. 2) Northeast 1/16 corner, Sec. 2. Not established in the original survey.

B. Description of corner evidence found and/or method applied in restoring or reestablishing corner:

(K3) The original post and accessories were not recovered. Reestablished the corner by double proportionate measurement to the original record between monumented corners 5279.45' west, 5110.27' north, 5305.15' east, and the intersection of the existing centerlines of Foy and Section 16 Roads 5266.2' south. From the position thus established, the distances to stream banks noted above to the west and south are at GLO record distance. The "leave stream" call to the north does not check - the stream does not cross the line between 1 and 2.
 (6-Sec. 2) Established the corner at the intersection of straight lines connecting opposite 1/16 corners.

C. Description of monument for corner and accessories established to perpetuate locating the position of the corner:

(K3) Set 1"IDx32" I.pipe with 4" alum. MDNR cap. Blazed, scribed, and set measuring nails in:	(6) Set 1"IDx32" I.pipe with 4" alum. MDNR cap. Blazed, scribed, and set measuring nails in:
9" Sugar N71E 11.3'	14" Hemlock S85E 13.1'
10" Sugar S38E 6.7'	4" Sugar S23E 12.4'
11" Sugar S80W 24.7'	7" Sugar S87W 14.7'
12" Cedar N40W 44.2'	11" Sugar N14W 24.0'
Set sq'd cedar post adjacent. Bearings are magnetic. Distances are to nail with tag.	Set Sq'd cedar post adjacent. Bearings are magnetic. Distances are to nail with tag.

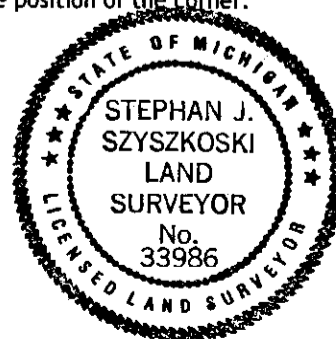

Signed by Stephan J. Szyszkoski
 Surveyor's Michigan License No. 33986

Date 8/30/04

For the Michigan Department of Natural Resources, Office of Land and Facilities