LAND CORNER RECORDATION CERTIFICATE
Filing Requirement of Act 74, Mich. P.A. 1970 as Amended

For corners in

Baraga
(County)

		Located In:		Corner Code #
1. Public Land Survey		T 48N	R 34W	C12
		T 48N	R 34W	D11
		T	R	
	S	T	R	
2. Property Controlling	S	T	R	
in Section	S	T	R	
3. Miscellaneous	S	T	R	
Property in Sec.	S	T	R	

Register of Deeds Stamp & File Number

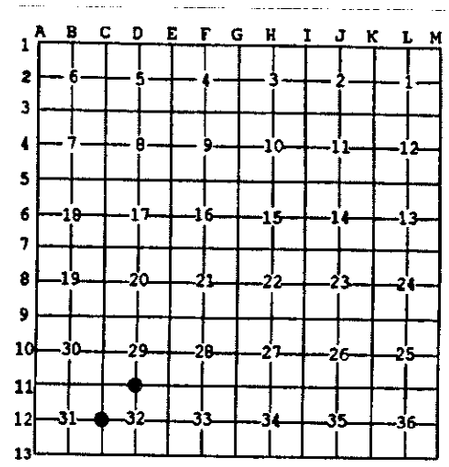

4. Lot No. _____ , Recorded Plat_____

5. Private Claims

D11 Jun 08 2004
C12 Jun 07 2004

I, Stephan J. Szyszkoski, in a field survey on _____, 20 ____ do hereby state that under requirements of P.A. 74, Michigan P.A. of 1970, the corner points mentioned in lines 1 and 2 above were in conformance with regulations and rules therefore as required in the current manual of survey instructions of the United States Department of the Interior, Bureau of Land Management or by a decree of a Court of Law and /or that the corner points mentioned in lines 3, 4 and 5 above were in conformance with the rules of the Michigan Board of Land Surveyors or by a Decree of a Court of Law; established, re-established, monumented, recovered, found as expressed below:

NOTE: Not more than 2 corners, all in the same town and range, may be recorded on this certificate.

A. Description of original monument and accessories and/or subsequent restoration:

(C12) Quarter corner common to Sections 31-32. 1853: Established by Francis Colman: [north] Corrected between 31&32...39.98 Set quarter section post. B.Ash 12 N29W 33 links, B.Ash 8 S20E 17 links. ...79.97 Set post cor. of sections 29-30-31-32.
(D11) Quarter corner common to Sections 29-32. 1853: Established by Francis Colman: [west] Corrected between 29&32...40.24 Set quarter section post. Fir 6 N67W 28 links, Hemlock 10 S64E 31 links. ...80.40 Sec. corner. *(Note: The First transcription of the GLO notes, obtained from the State Archives in Lansing, give those distances along the corrected line. However, the notes for the random line and the US Gov't township plat agree that the mile is 80.48 chains long).

B. Description of corner evidence found and/or method applied in restoring or reestablishing corner:

(C12) The original post and accessories were not recovered, having most certainly been destroyed by road construction. Found no monumentation at the corner position and no evidence on the ground of subsequent restoration. Reestablished the corner in the approximate center of the Ford Road, at a position midway and on a straight line between recorded corner C13 2623.57' south and a point 2623.57' north, said point being the intersection of the centerline of the Ford Road with an old fence line running westerly along the north line of Section 31. The corner C11 is not monumented. From the position thus established, the center of the Ford Road is 1.2' Easterly.
(D11) The original post and accessories were not recovered. The corner has been destroyed by road construction. Found and accepted a railroad spike at the intersection of the centerlines of the Maki and Niemi Roads. Distances east 2638.39' to E11 and west 2636.45' to the center of the Ford Road check fairly well with the record. Replaced the railroad spike with a monument described below.

C. Description of monument for corner and accessories established to perpetuate locating the position of the corner:

(C12) Set 1" IDx32" I.pipe with yellow plastic cap driven to just below flush with the pavement. Placed measuring nails with tags in:
Power Pole 77-2832 N64E 37.5'
Power Pole 77-2833 N77W 72.6'
Blazed, scribed, & set meas. nails in:
Spruce N51W 67.0' "1/4S NBT"
Cedar N29W 92.8' do
Bearings are magnetic. Distances are to nail with tag.

(D11) Set 1"IDx32" I.pipe with 4" alum. MDNR cap.
base of Stop Sign N67E 46.4'
Telephone post S37E 45.1' nail/tag
5" dbl Elm S59W 32.0' "1/4S NBT" set nail with tag.
Road sign "Niemi Rd" N75W 13.6'
Bearings are magnetic.

STATE OF MICHIGAN
STEPHAN J. SZYSZKOSKI
LAND SURVEYOR
No. 33986
LICENSED LAND SURVEYOR

Signed by Stephan J. Szyszkoski Date 8/25/04

Surveyor's Michigan License No. 33986

For the Michigan Department of Natural Resources, Office of Land and Facilities

FORM APPROVED BY MICHIGAN STATE BOARD OF PROFESSIONAL SURVEYORS, JAN. 28, 1971
Revised May 14, 1975
Revised Jan., 1983
Revised Oct., 1995