LAND CORNER RECORDATION CERTIFICATE
Filing Requirement of Act 74, Mich. P.A. 1970 as Amended

For corners in

Baraga
(County)

	Located In:		Corner Code #
1. Public Land Survey		T 48N R 34W	J1
		T 48N R 34W	I1
		T ___ R ___	
	S___	T ___ R ___	
2. Property Controlling	S___	T ___ R ___	
in Section	S___	T ___ R ___	
3. Miscellaneous	S___	T ___ R ___	
Property in Sec.	S___	T ___ R ___	

Register of Deeds Stamp & File Number

4. Lot No. _____ , Recorded Plat_____
5. Private Claims

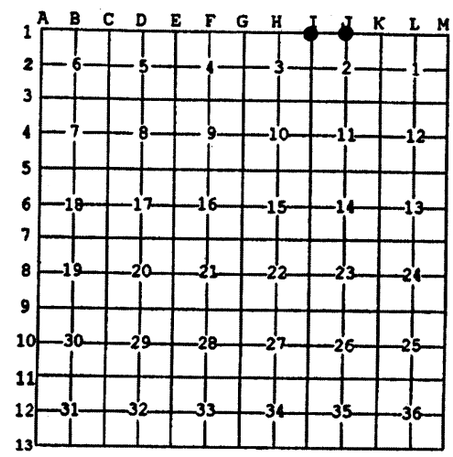

Jul 01 2004

I, Stephan J. Szyszkoski, in a field survey on _____, 20 ____ do hereby state that under requirements of P.A. 74, Michigan P.A. of 1970, the corner points mentioned in lines 1 and 2 above were in conformance with regulations and rules therefore as required in the current manual of survey instructions of the United States Department of the Interior, Bureau of Land Management or by a decree of a Court of Law and /or that the corner points mentioned in lines 3, 4 and 5 above were in conformance with the rules of the Michigan Board of Land Surveyors or by a Decree of a Court of Law; established, re-established, monumented, recovered, found as expressed below:

NOTE: Not more than 2 corners, all in the same town and range, may be recorded on this certificate.

A. Description of original monument and accessories and/or subsequent restoration:

(J1) Quarter corner common to Section 2 T48N-R34W and Section 35 T49N-R34W. 1846 - Established by Austin Burt midway between Section corners. Set Ironwood post. Sugar 24 N34E 33 links, Sugar 18 N46W 59 links. Found no subsequent record.
(I1) Corner common to Sections 2-3 T48N-R34W and 34-35 T49N-R34W. 1846 - Established by Austin Burt: West on South side of Section 35 (T49N-R34W)...80.00 Set Birch post corner of Secs 34&35. W.Birch 8 N60E 15 links, W.Birch 7 N10W 23 links. Additional BTs by Francis Colman 1853: Aspen 8 S30E 2 links, Aspen 8 S35W 25 links.

B. Description of corner evidence found and/or method applied in restoring or reestablishing corner:

(J1) The original post and accessories were not recovered. They have likely been destroyed by road building. Reestablished the corner on the township line and midway between reestablished Section corners 2648.72' east and west.
(I1) The original post and accessories were not recovered. Reestablished the corner on the township line and by single proportionate measurement to the original record between Township corner 10594.88' east and Section corner 10594.88' west. The easting of the position for this corner is consistent with the GLO record with respect to the location of corners I2 (found iron pipe) and I3 (reestablished from local evidence) to the south.

C. Description of monument for corner and accessories established to perpetuate locating the position of the corner:

(J1) Set 1"IDx32" I.pipe with 4" alum. MDNR cap. Blazed, scribed, and set measuring nails in:

7" Maple North 21.4'	"1/4S NBT"
5" Sugar S22E 40.8'	do
6" Maple S23W 48.4'	do
10" Maple West 54.1'	do

Set sq'd cedar post adjacent. Bearings are magnetic. Distances are to nail with tag.

(I1) Set 1"IDx32" I.pipe with 4" alum. MDNR cap. Blazed, scribed, and set measuring nails in:

13" Hemlock N14E 13.9'	"S35 NBT"
7" dbl Maple S88E 29.1'	"S2 NBT"
3" Hemlock S27W 19.5'	"S3 NBT"
10" Spruce S86W 27.1'	do

Set sq'd cedar post adjacent. Bearings are magnetic. Distances are to nail with tag.

STATE OF MICHIGAN
STEPHAN J. SZYSZKOSKI
LAND SURVEYOR
No. 33986
LICENSED LAND SURVEYOR

Signed by Stephan J. Szyszkoski Date 8/30/04

Surveyor's Michigan License No. 33986

For the Michigan Department of Natural Resources, Office of Land and Facilities

FORM APPROVED BY MICHIGAN STATE BOARD OF PROFESSIONAL SURVEYORS, JAN. 28, 1971
Revised May 14, 1975
Revised Jan., 1983
Rervised Oct., 1995