LAND CORNER RECORDATION CERTIFICATE
Filing Requirement of Act 74, Mich. P.A. 1970 as Amended

For corners in

Baraga
(County)

		Located In:	Corner Code #
1. Public Land Survey		T 48N R 34W	A1
		T 48N R 34W	C4
		T___ R___	
	S___	T___ R___	
2. Property Controlling	S___	T___ R___	
in Section	S___	T___ R___	
3. Miscellaneous	S___	T___ R___	
Property in Sec.	S___	T___ R___	

Register of Deeds Stamp & File Number

4. Lot No. _____ , Recorded Plat_____

5. Private Claims

C4 Jul 05 2006
A1 Jul 06 2006

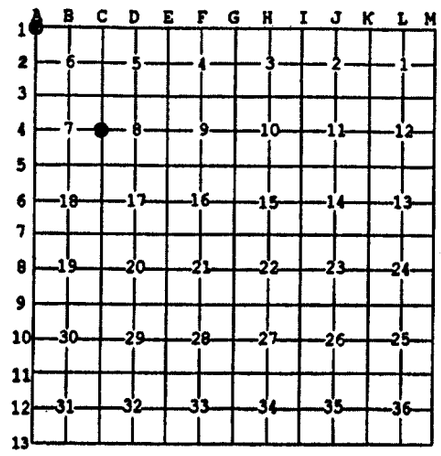

I, Stephan J. Szyszkoski, in a field survey on _____, 20 ____ do hereby state that under requirements of P.A. 74, Michigan P.A. of 1970, the corner points mentioned in lines 1 and 2 above were in conformance with regulations and rules therefore as required in the current manual of survey instructions of the United States Department of the Interior, Bureau of Land Management or by a decree of a Court of Law and /or that the corner points mentioned in lines 3, 4 and 5 above were in conformance with the rules of the Michigan Board of Land Surveyors or by a Decree of a Court of Law; established, re-established, monumented, recovered, found as expressed below:

NOTE: Not more than 2 corners, all in the same town and range, may be recorded on this certificate.

A. Description of original monument and accessories and/or subsequent restoration:

(A1) Township corner common to Townships 48 and 49 North and Ranges 34 and 35 West. 1958 - Reestablished by Billy D. Buckler from corners 4 miles north and 1 mile south. Set 1" pipe with 4" brass cap. 10" J.Pine N30W 22 links, 5" J.Pine S50E 43 links, 5" J.Pine S37W 63 links.
(C4) Quarter corner common to Sections 7 and 8. 1853 - Established by Francis Coleman, Deputy Surveyor: S36'E corrected between Secs 7 & 8 ...40.00 Set qr. Sec. post. Cedar 12 N23E 20 links, Hemlock 10 S11W 17 links. ...80.00 Cor. of Sections 7-8-17-18.

B. Description of corner evidence found and/or method applied in restoring or reestablishing corner:

(A1) Recovered the 1958 monument in good condition and at record bearing and distance from the 1958 witness trees: The J.Pine NW is in good condition, now 13" DBH, the J.Pine SE is dead and down, and the J.Pine SW is a stump. Left the monument in place and made new witnesses as described below.
(C4) The original post was not recovered. Remonumented the corner at record bearing and distance from the remains of the Cedar BT, now down, largely intact, approx. 12" DBH with about 2" of growth over the original blaze. Found scribing "BT" very clear with lower 1/2 of "S" also visible above. All other markings have rotted away. Found the corner position to be 2684.9' south of reestablished C3 and 5249.8' north of monumented C6. Note: the monument may have been incorrectly stamped like this: "1/4 7|6".

C. Description of monument for corner and accessories established to perpetuate locating the position of the corner:

(A1) Found 1"ID I.pipe with 4" brass MI Dept. of Conservation cap. Set measuring nails in:
13" J.Pine N24W 15.6' old marks vis. *
3" J.Pine N75E 18.7' mrkd "S31 NBT"
3" J.Pine S50E 20.5' "S6 NBT"
7" J.Pine S04W 18.1' "S1 NBT"
Metal sign post N85W 2.1'
Bearings are magnetic. Distances to trees are to nail with tag. * denotes 1958 NBT.

(C4) Set 1"IDx32" I.Pipe with 4" alum. MDNR cap. Set measuring nails in:
8" Sugar N64E 11.9' mrkd "1/4S NBT"
7" Sugar S45E 11.15' do
10" Sugar S64W 23.1' do
8" Hemlock N06W 42.5' do
Set sq'd cedar post (made from the original BT) adjacent. Bearings are magnetic. Distances are to nail with tag.

STATE OF MICHIGAN
STEPHAN J. SZYSZKOSKI
LAND SURVEYOR
No. 33986
LICENSED LAND SURVEYOR

Signed by Stephan J. Szyszkoski Date 8/2/06

Surveyor's Michigan License No. 33986

For the Michigan Department of Natural Resources, Office of Land and Facilities

FORM APPROVED BY MICHIGAN STATE BOARD OF PROFESSIONAL SURVEYORS, JAN. 28, 1971
Revised May 14, 1975
Revised Jan., 1983
Revised Oct., 1995