

**LAND CORNER RECORDATION CERTIFICATE**  
**Filing Requirement of Act 74, Mich. P.A. 1970 as Amended**

For corners in

Baraga	Located In:	Corner Code #
(County)		
1. Public Land Survey	T <u>48NR</u> <u>34W</u>	<u>82</u>
	T _____	_____
	T _____	_____
	S _____	_____
2. Property Controlling in Section	S <u>6</u> T <u>48NR</u> <u>34W</u>	<u>2</u>
	S _____	_____
3. Miscellaneous Property in Sec.	S _____	_____
	S _____	_____

Register of Deeds Stamp & File Number

4. Lot No. \_\_\_\_\_, Recorded Plat \_\_\_\_\_  
 5. Private Claims \_\_\_\_\_

Jul 12 2006

I, Stephan J. Szyszkoski, in a field survey on \_\_\_\_\_, 20\_\_\_\_ do hereby state that under requirements of P.A. 74, Michigan P.A. of 1970, the corner points mentioned in lines 1 and 2 above were in conformance with regulations and rules therefore as required in the current manual of survey instructions of the United States Department of the Interior, Bureau of Land Management or by a decree of a Court of Law and /or that the corner points mentioned in lines 3, 4 and 5 above were in conformance with the rules of the Michigan Board of Land Surveyors or by a Decree of a Court of Law; established, re-established, monumented, recovered, found as expressed below:

	A	B	C	D	E	F	G	H	I	J	K	L	M
1		●											
2		●		5	4	3							
3													
4	7		8		9	10		11		12			
5													
6	18		17		16	15		14		13			
7													
8	19		20		21	22		23		24			
9													
10	30		29		28	27		26		25			
11													
12	31		32		33	34		35		36			
13													

**NOTE: Not more than 2 corners, all in the same town and range, may be recorded on this certificate.**

A. Description of original monument and accessories and/or subsequent restoration:


(82) Center of Section 6. Not established in the original survey. Found no subsequent record.  
 (2-Sec. 6) East 1/16 corner between Section 6 T48N-R34W and Section 31 T49N-R34W. 1987 - Established by K.L.Sackett midway and on line. Set 1"IDx36" I.pipe with 4" aluminum cap. 6" J.Pine N63E 11.9', 3" J.Pine S19E 14.9', 12" J.Pine N68W 32.2'.

B. Description of corner evidence found and/or method applied in restoring or reestablishing corner:

(82) Established the corner at the intersection of straight lines connecting opposite 1/4 corners.  
 (2-Sec. 6) Recovered the 1987 monument and accessories. The 1987 position for this corner was controlled by a monument at B1 which subsequently has been rejected as erroneous. Therefore the 1987 monument at 1/16 corner #2 is also erroneous, it being N06W 18.0' from the proper and subsequently monumented position. Established the corner midway and on the Section line between B1 as reestablished by the undersigned, 1315.95' west and Section corner C1 1315.95' east. Destroyed the 1987 monument.

C. Description of monument for corner and accessories established to perpetuate locating the position of the corner:

(82) Set 1"IDx32" I.pipe with 4" alum. MDNR cap. Set measuring nails in: 5" J.Pine N26W 16.7'      mrkd "C1/4 BT" 5" J.Pine N31E 15.9'      do 3" J.Pine S65E 26.9'      do 3" J.Pine S40W 9.5'      do	(2) Set 1"IDx32" I.pipe with 4" alum. MDNR cap. Set measuring nails in: 9" J.Pine N22E 24.8' old scribing vis. 7" J.Pine N45E 5.8'      mrkd "1/16S BT" 7" J.Pine S12W 9.9'      do 6" J.Pine N75W 8.1'      do
Bearings are magnetic. Distances are to nail with tag. Set sq'd cedar post adjacent.	Set sq'd J.Pine post adjacent. Bearings are magnetic. Distances are to nail with tag.

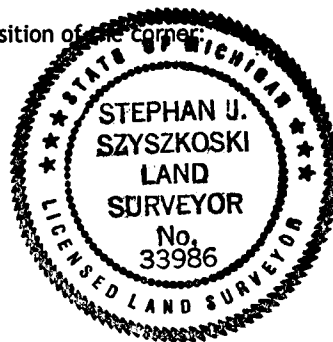

Signed by Stephan J. Szyszkoski  
 Surveyor's Michigan License No. 33986

Date 8/2/06