

**LAND CORNER RECORDATION CERTIFICATE**  
**Filing Requirement of Act 74, Mich. P.A. 1970 as Amended**

For corners in


<u>Baraga</u> (County)	Located In:	Corner Code #
1. Public Land Survey	T <u>48NR</u> <u>34W</u>	<u>C3</u>
	T _____ R _____	_____
	T _____ R _____	_____
2. Property Controlling in Section	S _____ T _____ R _____	_____
	S _____ T _____ R _____	_____
3. Miscellaneous Property in Sec.	S _____ T _____ R _____	_____
	S _____ T _____ R _____	_____

Register of Deeds Stamp & File Number

4. Lot No. \_\_\_\_\_, Recorded Plat \_\_\_\_\_  
 5. Private Claims \_\_\_\_\_

Jul 13 2006

I, Stephan J. Szyszkoski, in a field survey on \_\_\_\_\_, 20\_\_\_\_ do hereby state that under requirements of P.A. 74, Michigan P.A. of 1970, the corner points mentioned in lines 1 and 2 above were in conformance with regulations and rules therefore as required in the current manual of survey instructions of the United States Department of the Interior, Bureau of Land Management or by a decree of a Court of Law and /or that the corner points mentioned in lines 3, 4 and 5 above were in conformance with the rules of the Michigan Board of Land Surveyors or by a Decree of a Court of Law; established, re-established, monumented, recovered, found as expressed below:

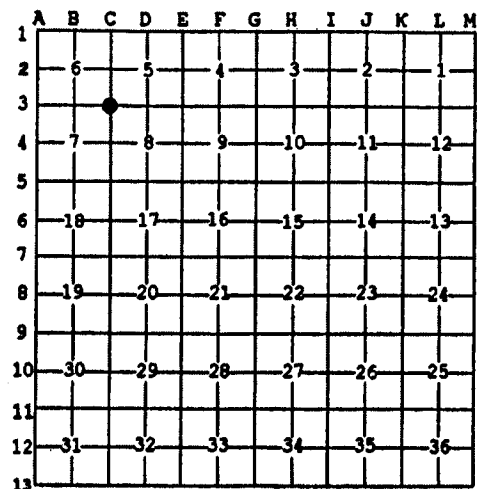

**NOTE:** Not more than 2 corners, all in the same town and range, may be recorded on this certificate.

A. Description of original monument and accessories and/or subsequent restoration:


(C3) Corner common to Sections 5-6-7-8. 1853 - Established by Francis Coleman, Deputy Surveyor: S36'E corrected between Secs. 5 & 6 ...37.10 Set qr. Sec. post on South side of bank...60.30 over Sturgeon River trigonometrically ...74.75 Top of Bank 80 ft. high C. E&W...77.10 Set post cor. of Secs. 5-6-7-8. Fir 10 N17W 45 links, Hemlock 12 S37E 19 links.

B. Description of corner evidence found and/or method applied in restoring or reestablishing corner:

(C3) The original post and accessories were not recovered. Reestablished the corner by proportionate measurement E-W between reestablished 83 2635.71' west (GLO rec. 40.00 chains) and E3 5276.33' east (GLO rec. 80.09 chains), and at record distance south of the "top of bank 80 ft." call 2.35 chains north. The bank is sharp and distinct. There is an overage of about 100' in the mile between Sections 5 and 6, compared to the original record. I suppose that errors in the original measure were introduced by inaccurate triangulation over the Sturgeon River and/or poor measurement or further blunders made in the south 1/2 mile, the terrain being difficult. The position for the corner is also supported by the clear and defined sequence of calls made on the line between 5 and 6 at 31.12 chains (left bank at bend of river), 33.70 (over bend on rocks at mouth of stream), and 37.00 (top of bank 80 ft.). These calls match the record very well in northing relative to the section line through E3 of record and C3, herein described.

C. Description of monument for corner and accessories established to perpetuate locating the position of the corner:

(C3) Set 1" IDx32" I.pipe with 4" alum.  
 MDNR cap. Set measuring nails in:  
 4" Spruce N04E 52.6' mrkd "S5 NBT"  
 5" Balsam S45E 44.2' "S8 NBT"  
 4" Hemlock S20W 35.3' "S7 NBT"  
 4" Balsam N57W 6.4' "S6 NBT"  
 Set sq'd cedar post adjacent. Bearings are magnetic. Distances are to nail with tag.

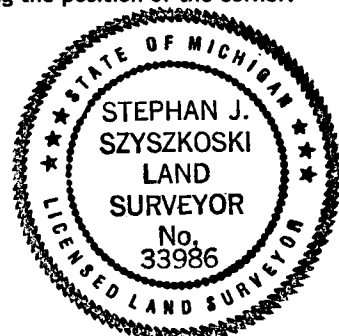

Signed by Stephan J. Szyszkoski  
 Surveyor's Michigan License No. 33986

Date 8/2/06