


LAND CORNER RECORDATION CERTIFICATE
Filing Requirement of Act 74, Mich. P.A. 1970

For corners in

Baraga	Located In:	Corner Code #	
(County)			
1. Public Land Survey	T ___ R ___	_____	
	T ___ R ___	_____	
	T ___ R ___	_____	
	T ___ R ___	_____	
2. Property Controlling in Section	S 10 T 49N R 32W	7	
	S 10 T 49N R 32W	6	
3. Miscellaneous Property in Sec.	S ___ T ___ R ___	_____	
	S ___ T ___ R ___	_____	

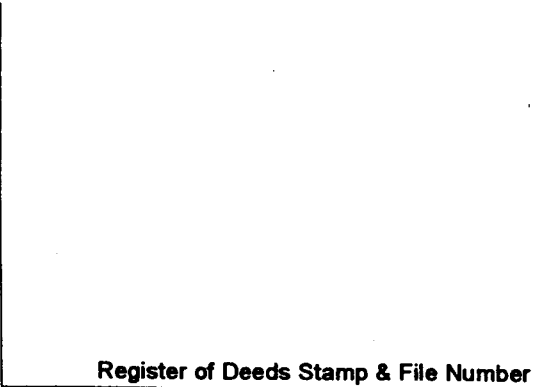

4. Lot No. _____, Recorded Plat _____
 5. Private Claims _____

Jun 10 2002

I, Stephan J. Szyszkoski, in a field survey on _____, 20__ do hereby state that under requirements of P.A. 74, Michigan P.A. of 1970, the corner points mentioned in lines 1 and 2 above were in conformance with regulations and rules therefore as required in the current manual of survey instructions of the United States Department of the Interior, Bureau of Land Management or by a decree of a Court of Law and /or that the corner points mentioned in lines 3, 4 and 5 above were in conformance with the rules of the Michigan Board of Land Surveyors or by a Decree of a Court of Law; established, re-established, monumented, recovered, found as expressed below:

NOTE: Not more than 2 corners, all in the same town and range, may be recorded on this certificate.

A	B	C	D	E	F	G	H	I	J	K	L	M
1												
2	6		5		4		3		2		1	
3												
4	7		8		9		10		11		12	
5												
6	18		17		16		15		14		13	
7												
8	19		20		21		22		23		24	
9												
10	30		29		28		27		26		25	
11												
12	31		32		33		34		35		36	
13												

A. Description of original monument and accessories and/or subsequent restoration:
 (7-Sec. 10) North 1/16 corner between 10 and 11. Not established in the original survey. N.T.Thompson, RLS chained the mile in 1942: "New B.T. at N1/8 Cedar 8 S45W 5.1, Cedar 10 N13E 26.2". And, "this line is run pocket compass from the north". Mead notes (1979?) state: "Found scribed cedar post down" at record bearing and distance from the 1942 wits. "Placed 1 1/4 I.P. in proper position". 1981: Recorded by K.L. Sackett, RLS: Found 1 3/8" I.D. by unknown length iron pipe set by Norman Thompson, RLS, Restored at Norman Thompson iron pipe. 16" Cedar S02E 24.6', 10" Cedar N55W 29.6', 12" Cedar N77E 25.7'.
 (6-Sec. 10) Northeast 1/16 corner, Section 10. Not established in the original survey.

B. Description of corner evidence found and/or method applied in restoring or reestablishing corner:
 (7-Sec. 10) Found 1 1/4" ID iron pipe at record bearing and distance from the 1981 record accessories. The pipe is N83W 17.0' from the proper 1/16 corner position, midway between Section and 1/4 corners. This corner was established using improper procedures and I do not accept the pipe as marking the 1/16 corner position. Established the corner midway and on a line of mean true bearing between Section corner 1315.96' north and 1/4 corner 1315.96' south. I left the pipe of record in place.
 (6-Sec. 10) Established the corner at the intersection of straight lines connecting opposite 1/16 corners.

C. Description of monument for corner and accessories established to perpetuate locating the position of the corner:

(7) Set 1"IDx32" I.pipe with 4" alum. MDNR cap. Blazed and scribed: 14" Cedar N38E 12.7' "1/16S BT" * 16" Cedar S38W 27.5' "1/16S BT" * 12" Cedar N61W 45.2' fd old scribing * 5" Sugar S08E 16.4' "1/16S BT"	(6) Set 1"IDx32" I.pipe with 4" alum. MDNR cap. Blazed and scribed: 6" twin Y.Birch N25E 21.2' "1/16S BT" 7" Sugar S66E 49.4' do 9" Y.Birch S02W 30.2' do 6" Maple S27E 12.1' do
---	--

* denotes 1981 BT of record. Bearings are magnetic. Distances are to notch in lower blaze.



Signed by Stephan J. Szyszkoski Date 7/11/02
 Surveyor's Michigan License No. 33986