

LAND CORNER RECORDATION CERTIFICATE
Filing Requirement of Act 74, Mich. P.A. 1970

For corners in

Baraga

(County)

Located In:

Corner Code #

- | | | | |
|------------------------------------|------|-------|----|
| 1. Public Land Survey | T49N | R 32W | E5 |
| | T49N | R 32W | D5 |
| 2. Property Controlling in Section | S | T | R |
| | S | T | R |
| 3. Miscellaneous Property in Sec. | S | T | R |
| | S | T | R |


Register of Deeds Stamp & File Number

4. Lot No. _____, Recorded Plat _____
 5. Private Claims _____

May 23 2002

I, Stephan J. Szyszkoski, in a field survey on _____, 20____ do hereby state that under requirements of P.A. 74, Michigan P.A. of 1970, the corner points mentioned in lines 1 and 2 above were in conformance with regulations and rules therefore as required in the current manual of survey instructions of the United States Department of the Interior, Bureau of Land Management or by a decree of a Court of Law and /or that the corner points mentioned in lines 3, 4 and 5 above were in conformance with the rules of the Michigan Board of Land Surveyors or by a Decree of a Court of Law; established, re-established, monumented, recovered, found as expressed below:

NOTE: Not more than 2 corners, all in the same town and range, may be recorded on this certificate.

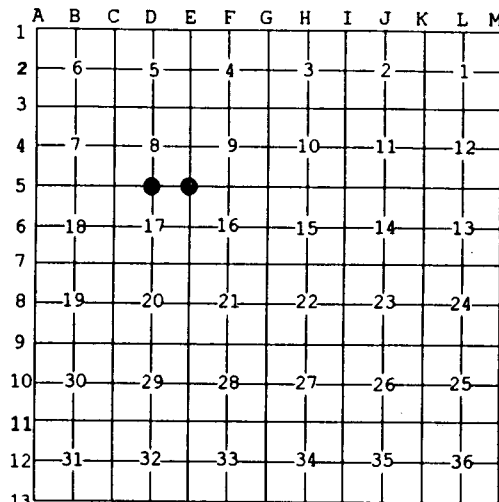

A. Description of original monument and accessories and/or subsequent restoration;

- (E5) Corner common to Sections 8-9-16-17. 1852: Established by Guy H. Carleton: "Set post corner of Secs. 8-9-16-17 Fir 14 N72E 30 links, White Pine 20 S59W 43 links." A long-time local land owner, John Taisto says that approx. 50 years ago this corner was marked by a squared and scribed wood post set in a mound of rocks. He remembers seeing it when he was a teen. Subsequently, he says, foresters removed the post from the mound and replaced it with a smaller post which has now rotted away.
- (D5) Quarter corner common to Sections 8 and 17. 1852: Established by Guy H. Carleton: "...39.70 Set quarter post. Yellow Birch 18 N10W 40 links, Sugar 7 S12E 3.5 links". Long-time local landowner John Taisto says that his grandfather set a fence corner post at this corner to perpetuate the original corner and that he, John Taisto, as a teen, approx. 50 years ago, also set a fence post here in what he believed was the post hole of the post previously set by his grandfather.

B. Description of corner evidence found and/or method applied in restoring or reestablishing corner:

- (E5) The original post and accessories were not recovered. Found a mound of rock about 3 ft. in dia., 1 ft. high, moss covered, with blue paint and Mead location poster on 5" sugar facing it. Mr. Taisto was present at the monumenting of this corner and says that this is the mound that supported the squared and scribed post 50 years ago. Distances to adjacent corners are reasonable considering the somewhat loose work of the original surveyor. I accepted the rock mound as the best available evidence of the position of the original corner.
- (D5) Found an old wood fence corner post with fencing north and east from it. Blue paint lines run to the east and west from the post. At record bearing and distance from the post, I found the ground-level stump remains of what I believe are the original Y.Birch and Sugar OBTs. I remonumented the corner at the position of the post.

C. Description of monument for corner and accessories established to perpetuate locating the position of the corner:

- | | |
|--|---|
| (E5) Set a 1"IDx32" I.Pipe with 4" dia. alum. MDNR cap in the rock mound and rebuilt to about 3.5 ft. dia. and 2 ft. high. Blazed and scribed: | (D5) Set 1"IDx32" I.pipe with 4" alum. MDNR cap. Blazed and scribed: |
| 13" W.Pine N22E 25.4' | 7" Sugar S62E 17.0' "1/4S NBT" |
| 4" Sugar S55E 3.7' | 10" Cedar S6W 64.1' do |
| 8" Oak S72W 18.3' | 14" Sugar S18W 20.3' do |
| 13" W.Pine N71W 16.5' | 11" Sugar N17W 19.5' do |
| Bearings are magnetic. Dist. to notch in lower blaze. | Placed a squared cedar post adjacent. Bearings are magnetic. Distances are to notch in lower blaze. |



Signed by Stephan J. Szyszkoski
 Surveyor's Michigan License No. 33986

Date 7/11/02