

LAND CORNER RECORDATION CERTIFICATE
Filing Requirement of Act 74, Mich. P.A. 1970

For corners in

Baraga	Located In:	Corner Code #
(County)		
1. Public Land Survey	T <u>49N</u> R <u>32W</u>	<u>613</u>
	T <u> </u> R <u> </u>	<u> </u>
	T <u> </u> R <u> </u>	<u> </u>
	T <u> </u> R <u> </u>	<u> </u>
2. Property Controlling in Section	S <u>34</u> T <u>49N</u> R <u>32W</u>	<u>15</u>
	S <u> </u> T <u> </u> R <u> </u>	<u> </u>
3. Miscellaneous Property in Sec.	S <u> </u> T <u> </u> R <u> </u>	<u> </u>
	S <u> </u> T <u> </u> R <u> </u>	<u> </u>

Register of Deeds Stamp & File Number

4. Lot No. _____, Recorded Plat _____
 5. Private Claims _____

613 Oct 27 2004
 15 Apr 21 2005

I, Stephan J. Szyszkoski, in a field survey on _____, 19____ do hereby state that under requirements of P.A. 74, Michigan P.A. of 1970, the corner points mentioned in lines 1 and 2 above were in conformance with regulations and rules therefore as required in the current manual of survey instructions of the United States Department of the Interior, Bureau of Land Management or by a decree of a Court of Law and /or that the corner points mentioned in lines 3, 4 and 5 above were in conformance with the rules of the Michigan Board of Land Surveyors or by a Decree of a Court of Law; established, re-established, monumented, recovered, found as expressed below:

NOTE: Not more than 2 corners, all in the same town and range, may be recorded on this certificate.

	A	B	C	D	E	F	G	H	I	J	K	L	M
1													
2		6		5		4		3		2		1	
3													
4		7		8		9		10		11		12	
5													
6		18		17		16		15		14		13	
7													
8		19		20		21		22		23		24	
9													
10		30		29		28		27		26		25	
11													
12		31		32		33		34		35		36	
13													


A. Description of original monument and accessories and/or subsequent restoration:
 (G13) Corner common to Sections 33-34 T49N-R32W and Sections 3-4 T48N-R32W. 1948: N.T. Thompson notes "5-28-48 [BTs] Gone. Found old post set new ced. post in pile of rock. New BT spr 4 N44E 9.7, W.Bir. [record here is incomplete or erroneous -SJS]. 1975: Remonumented by K.L. Sackett at the 1948 position as determined by found scribed post and found NBT 8" Spruce N47E 9.8 feet. Set 1"IDx36" iron pipe with 4" aluminum cap. New BTs 10" W.Birch N78W 33.3', 6" Cedar S63E 32.8'.
 (15-Sec. 34) West 1/16 corner between Sec. 34 T49N-R32W and Section 3 T48N-R32W. Not established in the original survey.

B. Description of corner evidence found and/or method applied in restoring or reestablishing corner:

(G13) Found and accepted the 1975 monument in good condition at record bearing and distance from the 1975 witness trees. The 10" W.Birch is now dead, the Cedar SE, now 12" DBH is in good condition with notch and scribing visible.
 (15-Sec. 34) Established the corner midway between Section corner 1316.59' west and Quarter corner 1316.59' east, and on the curved township line of constant true bearing (rhumb line) between them.

C. Description of monument for corner and accessories established to perpetuate locating the position of the corner:

(G13) Found 1"ID I.pipe with 4" alum. MDNR cap. Set measuring nails in: 12" dbl Cedar S59E 32.8' * 9" Spruce S89W 33.9' mrkd "S4 NBT" 6" Maple in clump S36W 32.7' do 13" Spruce N01W 28.8' "S33 NBT" Sq'd spruce post adjacent. Bearings are magnetic. Distances are to nail with tag. † denotes 1975 NBT.	(15) Set 1"IDx32" I.pipe with 4" alum. MDNR cap. Set measuring nails in: 8" Maple N59E 6.3' mrkd "1/16S BT" 16" Cedar S26W 45.5' do 7" Maple N81W 29.3' do 16" Tamarack N16W 32.4' do Set sq'd cedar post adjacent. Bearings are magnetic. Distances are to nail with tag.
--	---

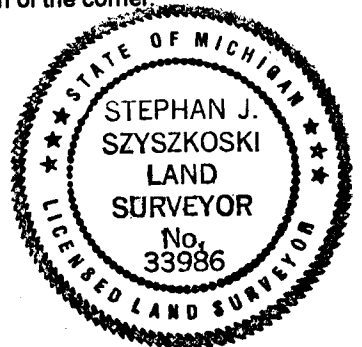

Signed by Stephan J. Szyszkoski
 Surveyor's Michigan License No. 33986

Date 6/13/05