LAND CORNER RECORDATION CERTIFICATE

Filing Requirement of Act 74, Mich. P.A. 1970 as Amended

For corners in

Baraga (County) Located In: Corner Code #

1. Public Land Survey		T 49N	R 32W	E12
		T	R	
		T	R	
2. Property Controlling in Section	S	T	R	
	S	T	R	
	S	T	R	
3. Miscellaneous Property in Sec.	S	T	R	
	S	T	R	

4. Lot No. _____, Recorded Plat _____

5. Private Claims

Register of Deeds Stamp & File Number

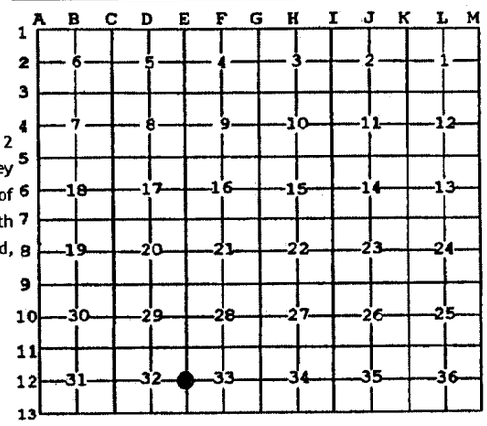

I, Stephan J. Szyszkoski, in a field survey on 12/16/2008 do hereby state that under requirements of P.A. 74, Michigan P.A. of 1970, the corner points mentioned in lines 1 and 2 above were in conformance with regulations and rules therefore as required in the current manual of survey instructions of the United States Department of the Interior, Bureau of Land Management or by a decree of a Court of Law and /or that the corner points mentioned in lines 3, 4 and 5 above were in conformance with the rules of the Michigan Board of Land Surveyors or by a Decree of a Court of Law; established, re-established, monumented, recovered, found as expressed below:

NOTE: Not more than 2 corners, all in the same town and range, may be recorded on this certificate.

A. Description of original monument and accessories and/or subsequent restoration:

(E12) Quarter corner common to Sections 32 and 33. 1852 - Established by Guy Carleton Deputy Surveyor midway and on the Section line between Section corners 40.06 chains north and south. Set post. Hemlock 20 S54E 07 links, Hemlock 24 S05W 33 links. 1988 - monumented by K.L.Sackett RLS midway and on line between Section corners. Set 1"IDx36" I.pipe with 4" aluminum MDNR cap. 10" Sugar N10W 34.2', 14" Hemlock S68E 7.8', 7" Cedar S14W 41.0'.

B. Description of corner evidence found and/or method applied in restoring or reestablishing corner:

(E12) The original post and accessories were not recovered. Found but did not accept the 1988 monument, in good condition. The 1988 position is based upon the 1978 monumentation of Section corner E13. The 1978 E13 was not accepted and has been reestablished and monumented by the undersigned, rendering the 1988 position of E12 incorrect. Reestablished corner E12 midway and on the Section line between Section corners 2647.42' north and south. The 1988 monument, recovered N39W 49.1' distant, was removed.

C. Description of monument for corner and accessories established to perpetuate locating the position of the corner:

(E12) Set 1"IDx32" I.pipe with 4" alum. MDNR cap.
Set measuring nail with MDNR tag in the side of:
5" Maple N10E 19.55' mrkd "1/4S NBT"
8" Sugar S55E 28.8' do
16" Sugar S13E 27.25' do
10" Maple S79W 14.6' do
Set sq'd cedar post adjacent.
Bearings are magnetic.

STATE OF MICHIGAN
STEPHAN J. SZYSZKOSKI
LAND SURVEYOR
No. 33986
LICENSED LAND SURVEYOR

Signed by Stephan J. Szyszkoski Date 01/12/2009

Surveyor's Michigan License No. 33986

For the Michigan Department of Natural Resources, Office of Land and Facilities

FORM APPROVED BY MICHIGAN STATE BOARD OF PROFESSIONAL SURVEYORS, JAN. 28, 1971
Revised May 14, 1975
Revised Jan., 1983
Revised Oct., 1995

16204