LAND CORNER RECORDATION CERTIFICATE

Filing Requirement of Act 74, Mich. P.A. 1970 as Amended

For corners in

Baraga (County) Located In: Corner Code #

1. Public Land Survey			T		R		
			T		R		
			T		R		
2. Property Controlling	S	32	T	49N	R	32W	16
in Section	S	32	T	49N	R	32W	7
	S		T		R		
3. Miscellaneous	S		T		R		
Property in Sec.	S		T		R		

4. Lot No. _____, Recorded Plat _____

5. Private Claims

Register of Deeds Stamp & File Number

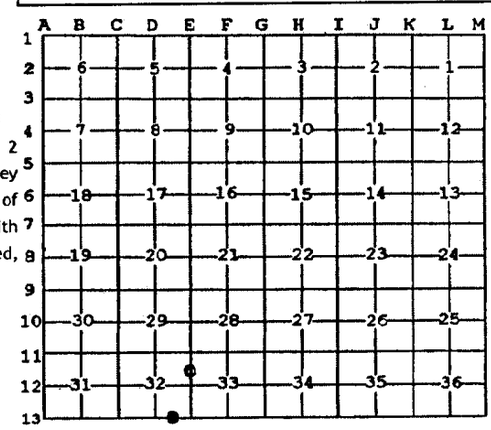

I, Stephan J. Szyszkoski, in a field survey on 16 12/09/2008 7 11/12/2008 do hereby state that under requirements of P.A. 74, Michigan P.A. of 1970, the corner points mentioned in lines 1 and 2 above were in conformance with regulations and rules therefore as required in the current manual of survey instructions of the United States Department of the Interior, Bureau of Land Management or by a decree of a Court of Law and /or that the corner points mentioned in lines 3, 4 and 5 above were in conformance with the rules of the Michigan Board of Land Surveyors or by a Decree of a Court of Law; established, re-established, monumented, recovered, found as expressed below:

NOTE: Not more than 2 corners, all in the same town and range, may be recorded on this certificate.

A. Description of original monument and accessories and/or subsequent restoration:

(16-Sec. 32) East 1/16 corner between Section 32 T49N-R32W and Section 5 T48N-R32W. Not established in the original survey.

(7-Sec. 32) North 1/16 corner between Sections 32 and 33. 1988 - Corner monumented by K.L.Sackett RLS, midway and on line between Section and Quarter corners. Set 1"x36" I.pipe with 4" aluminum MDNR cap. 16" Cedar S38W 37.4', 10" Cedar N76E 20.6', 5" Maple N42W 22.8'.

B. Description of corner evidence found and/or method applied in restoring or reestablishing corner:

(16-Sec. 32) Established the corner midway and on the Township line between Quarter corner 1319.02' west and Section corner 1319.02' east.

(7-Sec. 32) Found but did not accept the 1988 monument. The 1988 position was calculated from and monumented in accordance with a position for Quarter corner E12 which is judged by the undersigned to be incorrect. Established the position for the corner midway and on the Section line between Section corner 1323.71' north and Quarter corner (monumented Dec. 16, 2008) 1323.71' south. Removed the 1988 monument which was found N39W 25' distant.

C. Description of monument for corner and accessories established to perpetuate locating the position of the corner:

(16) Set 1"IDx32" I.pipe with 4" alum. MDNR cap.
Set measuring nail with MDNR tag in the side of:
8" W.Pine N49E 25.8' mrkd "1/16S BT"
5" Sugar S48E 4.8' do
15" W.Pine S61W 26.1' do
12" W.Pine N23W 12.4' do
Set sq'd Cedar post adjacent.
Bearings are magnetic.

(7) Set 1"IDx32" I.pipe with 4" alum. MDNR cap.
Set measuring nail with MDNR tag in the side of:
16" Cedar S72W 35.7' old marks (1988 BT)
6" Sugar N38W 47.5' do do
10" Cedar N16E 26.2' mrkd "1/16S BT" do
20" Hemlock S10E 7.2' do
Set sq'd cedar post adjacent.
Bearings are magnetic.

Signed by Stephan J. Szyszkoski Date 01/12/2009

Surveyor's Michigan License No. 33986

STATE OF MICHIGAN STEPHAN J. SZYSZKOSKI LAND SURVEYOR No. 33986 LICENSED LAND SURVEYOR

For the Michigan Department of Natural Resources, Office of Land and Facilities

16196

16198

FORM APPROVED BY MICHIGAN STATE BOARD OF PROFESSIONAL SURVEYORS, JAN. 26, 1971
Revised May 14, 1975
Revised Jan., 1983
Revised Oct., 1995