

LAND CORNER RECORDATION CERTIFICATE
Filing Requirement of Act 74, Mich. P.A. 1970 as Amended

For corners in

<u>Baraga</u> (County)	Located In:	Corner Code #
1. Public Land Survey	T _____ R _____	_____
	T _____ R _____	_____
	T _____ R _____	_____
2. Property Controlling in Section	S 32 T 49N R 32W	4
	S 32 T 49N R 32W	12
	S _____ T _____ R _____	_____
3. Miscellaneous Property in Sec.	S _____ T _____ R _____	_____
	S _____ T _____ R _____	_____
4. Lot No. _____, Recorded Plat _____		
5. Private Claims _____		

Register of Deeds Stamp & File Number

	A	B	C	D	E	F	G	H	I	J	K	L	M
1													
2	6			5			4		3			2	1
3													
4	7			8			9		10			11	12
5													
6	18			17			16		15			14	13
7													
8	19			20			21		22			23	24
9													
10	30			29			28		27			26	25
11													
12	31			32			33		34			35	36
13													

I, Stephan J. Szyszkoski, in a field survey on 07/07/2009 do hereby state that under requirements of P.A. 74, Michigan P.A. of 1970, the corner points mentioned in lines 1 and 2 above were in conformance with regulations and rules therefore as required in the current manual of survey instructions of the United States Department of the Interior, Bureau of Land Management or by a decree of a Court of Law and /or that the corner points mentioned in lines 3, 4 and 5 above were in conformance with the rules of the Michigan Board of Land Surveyors or by a Decree of a Court of Law; established, re-established, monumented, recovered, found as expressed below:

NOTE: Not more than 2 corners, all in the same town and range, may be recorded on this certificate.

A. Description of original monument and accessories and/or subsequent restoration:

(4-Sec. 32) Northwest 1/16 corner, Section 32. Not established in the original survey.

(12-Sec. 32) South 1/16 corner, Section 32. 1988 - Established by K.L.Sackett RLS during section subdivision. Set 1"IDx32" I.pipe with 4" aluminum cap. 10" W.Pine S57E 15.4', 8" Cedar S34W 21.8', 5" Cedar N69W 13.1'.

B. Description of corner evidence found and/or method applied in restoring or reestablishing corner:

(4-Sec. 32) Established the corner at the intersection of straight lines connecting opposite 1/16 corners.

(12-Sec. 32) Found but did not accept the 1988 monument of record. The 1988 position was calculated and monumented in accordance with a position for the Center of Section 32 which was not correct and which has now been remonumented by the undersigned. Established the corner midway and on a straight line between Quarter corner 1315.97' south and Center of Section 32 1315.97' north. Removed the 1988 monument. The 1988 W.Pine is in good condition, the 1988 cedar BTs were cut down. The monument falls on a high cliff edge, the terrain dropping sharply to the SW.


C. Description of monument for corner and accessories established to perpetuate locating the position of the corner:

(4) Set 1"IDx32" I.pipe w/ 4" alum. MDNR cap made firm in a mound of rock. Set meas. nail with MDNR tag in the side of:
 6" Sugar N16W 1.7' mrkd "1/16S BT"
 10" Hemlock N87E 18.0' do
 9" Sugar S04W 6.1' do
 8" Sugar S42W 9.1' do
 Nail in root N45E 0.68'
 Nail in root S55E 0.5'
 Bearings are magnetic.

(12) Set 1"IDx32" I.pipe with 4" alum. MDNR cap. Set measuring nail with MDNR tag in the side of:
 7" Spruce N27E 7.0' mrkd "1/16 BT"
 10" Poplar N49E 5.4' do
 3" Maple S05E 6.85' do
 Maple N31W 6.0' do
 Set sq'd cedar post adjacent.
 Bearings are magnetic.

Signed by Stephan J. Szyszkoski
 Surveyor's Michigan License No. 33986

Date 07/09/2009

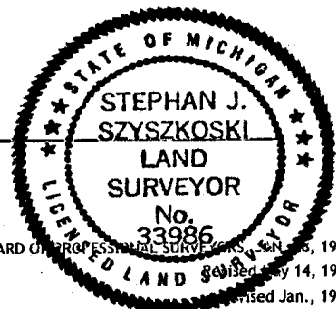

For the Michigan Department of Natural Resources, Office of Land and Facilities