


LAND CORNER RECORDATION CERTIFICATE
Filing Requirement of Act 74, Mich. P.A. 1970

For corners in

<u>Baraga</u> (County)	Located In:	Corner Code #	
1. Public Land Survey	T <u>49N</u> R <u>34W</u>	<u>011</u>	
	T <u>49N</u> R <u>34W</u>	<u>013</u>	
	T _____ R _____	_____	
	T _____ R _____	_____	
2. Property Controlling in Section	S _____ T _____ R _____	_____	
	S _____ T _____ R _____	_____	
3. Miscellaneous Property in Sec.	S _____ T _____ R _____	_____	
	S _____ T _____ R _____	_____	

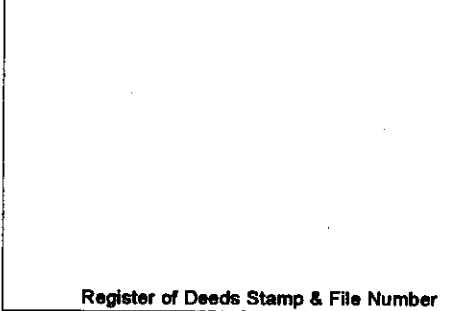

4. Lot No. _____, Recorded Plat _____
 5. Private Claims _____

Feb 07 2000

I, Stephan J. Szyszkoski, in a field survey on _____, 19____ do hereby state that under requirements of P.A. 74, Michigan P.A. of 1970, the corner points mentioned in lines 1 and 2 above were in conformance with regulations and rules therefore as required in the current manual of survey instructions of the United States Department of the Interior, Bureau of Land Management or by a decree of a Court of Law and /or that the corner points mentioned in lines 3, 4 and 5 above were in conformance with the rules of the Michigan Board of Land Surveyors or by a Decree of a Court of Law; established, re-established, monumented, recovered, found as expressed below:

NOTE: Not more than 2 corners, all in the same town and range, may be recorded on this certificate.

A	B	C	D	E	F	G	H	I	J	K	L	M
1												
2	6	5	4	3	2	1						
3												
4	7	8	9	10	11	12						
5												
6	10	17	16	15	14	13						
7												
8	19	20	21	22	23	24						
9												
10	30	29	28	27	26	25						
11												
12	31	32	33	34	35	36						
13												

A. Description of original monument and accessories and/or subsequent restoration:
 (D11) Quarter corner common to Sections 29-32. Corner reestablished in 1959 by Billy D. Buckler RLS: " Reestablished midway and on line between two sec. cors. No evidence of original cor. Cor. placed and wit. 5/13/59 with L.Stevens, D.F. 1" Pipe with 4" brass cap. 8" J. Pine S06W 13.5 links, 9" J. Pine N12E 20 links."
 (D13) Quarter corner common to Section 32, T49N-R34W and Section 5 T48N-R34W. Reestablished in 1959 by Billy D.Buckler, RLS midway and on line between Section corners. 1" pipe with 4" brass cap. 10" R. Pine N01W 40 links, 13" R. Pine S22E 54 links.

B. Description of corner evidence found and/or method applied in restoring or reestablishing corner:
 (D11) Recovered the 1959 monument, as described, apparently undisturbed, at record bearing and distance from the dead and down remains of the 1959 witnesses. Determined that the position of the 1959 monument is erroneous, being 32.2' east of the position of record. I removed the 1959 monument and reestablished the corner midway and on a line of mean true bearing between section corners 2623.78' east and west, being proportionate to the original record. At the position for the corner I placed a 1" ID x 36" iron pipe capped with a yellow plastic cap stamped "MICH DHR PS 33986".
 (D13) Recovered the 1959 monument as described, a 1" ID iron pipe capped with a 4" brass MI Dept. of Conservation tablet, appropriately stamped, in good condition, and at record bearing and distance from the 1959 witness trees, both recovered. I determined that the position of the 1959 monument is erroneous, being N12W 27.8' from the position of record. I removed the 1959 monument and reestablished the corner midway and on a line of mean true bearing between Section corners 2629.23' east and west, being proportionate to the original record. I placed the 1959 monument at this reestablished position.

C. Description of monument for corner and accessories established to perpetuate locating the position of the corner:
 (D11) Set 1" pipe with plastic cap. Blazed and scribed the following:
 5" J. Pine East 56.4' "1/4S N8T"
 4" J. Pine N43E 53.9' do
 5" J. Pine S48E 44.4' do
 7" J. Pine S12E 10.1' do
 4" J. Pine N11W 16.9' do
 a 4"x4" blue painted post with location poster and a squared J.Pine post are adjacent. Bearings are magnetic. Dist. to notch in lower blaze.
 (D13) Set 1" pipe with 4" brass MI Dept. of Conservation cap. Blazed and scribed the following:
 8" J.Pine N50W 13.9' "1/4S N8T"
 8" B.Spruce N02E 47.1' do
 9" J.Pine N83E 35.6' do
 17" R.Pine S39E 9.0' (marked in 1959)
 Placed a squared W.Pine post adjacent. Bearings are magnetic. Distances are to notch in lower blaze.



Signed by Stephan J. Szyszkoski Date 4/12/00
 Surveyor's Michigan License No. 33986

For the Michigan Department of Natural Resources - Forest Management Division