

SURVEY & REMONUMENTATION

APR 26 1995

LAND CORNER RECORDATION CERTIFICATE Filing Requirement of Act 74, Mich. P.A. 1970

COMMISSION

For corners in

Baraga

(County)

Located In:

50N 32W

Corner Code #

G-1

- | | | | | | |
|------------------------------------|---|-------|---|-------|-------|
| 1. Public Land Survey | T | _____ | R | _____ | _____ |
| | T | _____ | R | _____ | _____ |
| | T | _____ | R | _____ | _____ |
| | T | _____ | R | _____ | _____ |
| 2. Property Controlling in Section | S | _____ | T | _____ | R |
| | S | _____ | T | _____ | R |
| 3. Miscellaneous Property in Sec. | S | _____ | T | _____ | R |
| | S | _____ | T | _____ | R |
4. Lot No. _____, Recorded Plat _____
5. Private Claims _____

RECEIVED FOR RECORD THIS 19TH DAY OF DECEMBER, A.D. 1994 AT 9:00 A.M. AND RECORDED IN LIBER 4 OF LAND CORNER RECORDATION ON PAGES 509-510.

Allen J. Schilt
BARAGA COUNTY REGISTER OF DEEDS

Register of Deeds Stamp & File Number

Michael Mileski

April 94

I, Michael Mileski, in a field survey on _____, 19____, do hereby certify that under requirements of P.A. 74, Michigan P.A. of 1970; the corner points mentioned in lines 1 and 2 above were in conformance with regulations and rules therefore as required in the current manual of survey instructions of the United States Department of the Interior, Bureau of Land Management or by a decree of a Court of Law and/or that the corner points mentioned in lines 3, 4 and 5 above were in conformance with the rules of the Michigan Board of Land Surveyors or by a Decree of a Court of Law; established, re-established, monumented, re-monumented, recovered, found as expressed below:

NOTE: Not more than 4 corners, all in the same town and range, may be recorded on this certificate.

A	B	C	D	E	F	G	H	I	J	K	L	M
2	6	5	4	3	2	1						
3												
4	7	8	9	10	11	12						
5												
6	18	17	16	15	14	13						
7												
8	19	20	21	22	23	24						
9												
10	30	29	28	27	26	25						
11												
12	31	32	33	34	35	36						
13												


A. Description of original monument and accessories and/or subsequent restoration:

G-1; Closing Corner between Sections 3 and 4, T50N, R32W;

See back of form.

APPROVED LAND CORNER
P.A. 345 OF 1990
Baraga County

12-9-94

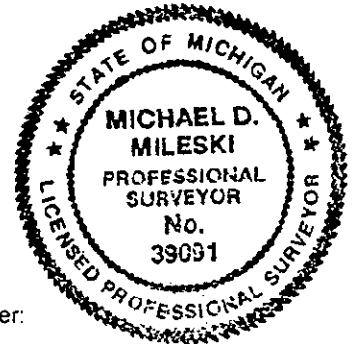

B. Description of corner evidence found and/or method applied in restoring or reestablishing corner:

G-1; Closing Corner between Sections 3 and 4, T50N, R32W;

Recovered both of Mr. Thompson's new bearing trees, the condition of each as indicated in Part A. Remonumented the corner at the intersection of Mr. Thompson's record distances from his new bearing trees. From this point recovered a hemlock stump of indeterminate size and fallen partial hemlock trunk overgrown with dead yellow birch roots at record U.S. bearing and distance (S33°W 14 lks = 9.24 feet). Accepted as a careful and faithful perpetuation of the position of the original corner.

C. Description of monument for corner and accessories established to perpetuate locating the position of the corner:

G-1; Closing Corner between Sections 3 and 4, T50N, R32W;

Set 1" (I.D.) x 36" galvanized iron pipe with 2" aluminum cap appropriately stamped as to location.

Set 60d spike	NW/side	11" Sugar Maple	N14°E	15.70'
Set 60d spike	NE/side	17" Sugar Maple	S71°E	30.48'
Set 60d spike	SE/side	11" Sugar Maple	S11°W	25.96'
Set 60d spike	N/side	16" Sugar Maple	N82°W	13.10'

All of the above new bearing trees marked with upper and lower face blazes and scribed "NBT".

Signed by Michael Mileski Date 19 December 1994

Surveyor's Michigan License No. 39091

A. Description of original monument and accessories and/or subsequent restoration:

G-1; Closing Corner between Sections 3 and 4, T50N, R32W;

Originally established during U.S. Survey conducted by Wm. A. Burt, D.S. in 1849 and monumented with a hemlock post witnessed by a

Hemlock 16 S33°W 14 lks. (Refer to Part B)

and a

Hemlock 14 S24°E 50 lks. (Gone)

The late Norman Thompson, RLS #4348 states in his field notes dated 2 December 1941 (copies of which were obtained from the Northern Hardwoods' office in L'Anse) that he set a post (type unknown) witnessed by a

Sugar 7" S38°E 28'

(Presently alive and 18" in dia. having healed lower face blaze
Set 60d spike W/side S41°E 28.00')

and a

Sugar 8 S15°W 18'9"

(Recovered as a 9" dia. stump and fallen partial trunk having no visible marks.)

Mr. Thompson does not explicitly state how he set the post but his field notes say "the distance checked from corner 31 and 36" indicating that he did not set the corner by measurement. I am of the opinion that Mr. Thompson recovered at least one probable U.S. bearing tree and not having any positively identifiable marks measured to the township corner to verify.

Keith Sackett, P.S., Baraga County Representative, and I examined the physical evidence described above on 12 May 1994.