

APR 08 1996

COMMISSION

LAND CORNER RECORDATION CERTIFICATE
Filing Requirement of Act 74, Mich. P.A. 1970

For corners in Baraga
(County)

Located In:

Corner Code #

- 1. Public Land Survey

T	<u>50N</u>	R	<u>32W</u>	<u>A-1</u>
T	<u>50N</u>	R	<u>33W</u>	<u>M-1</u>
T	_____	R	_____	_____
T	_____	R	_____	_____
- 2. Property Controlling in Section

S	_____	T	_____	_____
S	_____	T	_____	_____
- 3. Miscellaneous Property in Section

S	_____	T	_____	_____
S	_____	T	_____	_____

RECEIVED FOR RECORD THIS 28TH DAY OF DECEMBER A.D. 1995 AT 10:30 AM AND RECORDED IN LIBER 4 OF LAND CORNER RECORDATION ON PAGES 581 - 582.

Hilda J. Robillard
BARAGA COUNTY REGISTER OF DEEDS
Register of Deeds Stamp & File Number

- 4. Lot No. _____, Recorded Plat _____
- 5. Private Claims _____

A	B	C	D	E	F	G	H	I	J	K	L
2	6	5	4	3	2	1					
3											
4	7	8	9	10	11	12					
5											
6	18	17	16	15	14	13					
7											
8	19	20	21	22	23	24					
9											
10	30	29	28	27	26	25					
11											
12	31	32	33	34	35	36					
13											

I, Michael Mileski, in a field survey on December, 1995, do hereby certify that under requirements of P.A. 74, Michigan P.A. of 1970, the corner points mentioned in lines 1 and 2 above were in conformance with regulations and rules therefore as required in the current manual of survey instructions of the United States Department of the Interior, Bureau of Land Management or by a decree of a Court of Law and/or that the corner points mentioned in lines 3, 4 and 5 above were in conformance with the rules of the Michigan Board of Professional Surveyors or by a Decree of a Court of Law; established, re-established, monumented, re-monumented, recovered, found as expressed below:

NOTE: Not more than 4 corners, all in the same town and range, may be recorded on this certificate.

A. Description of original monument and accessories and/or subsequent restoration:

A-1, M-1; Section Corner common to Section 6, T50N, R32W and Section 1, T50N, R33W.

See back of form.

APPROVED LAND CORNER
P.A. 345 OF 1990
Baraga County
12-19-95
[Signature]

B. Description of corner evidence found and/or method applied in restoring or reestablishing corner:


A-1, M-1; Section Corner common to Section 6, T50N, R32W and Section 1, T50N, R33W.

Found BLM amended monument to be in agreement with the BLM new bearing trees listed in Part A. Monumented the original position of the closing corner from the BLM amended monument at record BLM bearing and distance. This position is in agreement with the remains of the U.S. bearing trees as described in Part A. Accepted as a careful and faithful perpetuation of the position of the original corner.

C. Description of monument for corner and accessories established to perpetuate locating the position of the corner:

A-1, M-1; Section Corner common to Section 6, T50N, R32W and Section 1, T50N, R33W.

See back of form.

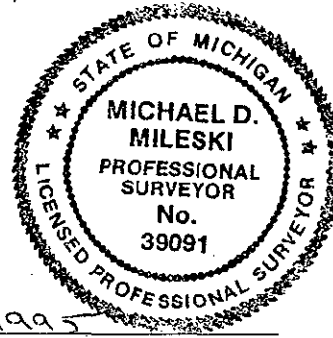

Signed by *[Signature]*
Surveyor's Michigan License No. 39091

Date 28 Dec 1995

A. Description of original monument and accessories and/or subsequent restoration:

A-1, M-1; Section Corner common to Section 6, T50N, R32W and Section 1, T50N, R33W.

Originally established during U.S. Survey conducted by William Burt, D.S. in 1846 and monumented with a hemlock post witnessed by a

Yellow Pine 16 S56°W 4 lks.
(Recovered as a stump hole.)

and a

Yellow Pine 16 S59°E 13 lks.
(Recovered as a stump hole.)

This corner was recovered by Michael Avery and Stephen Douglas of the Bureau of Land Management during the course of a survey conducted from 17 September 1982 to 30 September 1983 and approved 8 July 1985. According to field notes of this survey both U.S. bearing trees were recovered as badly decayed pine stumps of indeterminate size having no marks visible. The BLM did not remonument the original closing corner but rather established an amended position at the intersection of the range line with the correction line and monumented it with a 2½" aluminum pipe with a 3" cap appropriately stamped as to location. Per the BLM field notes the original closing corner bears S00°01'W a distance of 0.149 chains (9.83 feet) from the amended monument. The BLM established the following new bearing trees for the amended monument:

Maple 6 S14°E 165 lks.

and a

Maple 6 S35°W 170 lks.

C. Description of monument for corner and accessories established to perpetuate locating the position of the corner.

A-1, M-1; Section Corner common to Section 6, T50N, R32W and Section 1, T50N, R33W.

Set 1" (I.D.) x 36" galvanized iron pipe with 2" aluminum cap appropriately stamped as to location at the position of the original closing corner. This corner is located in an old clear cut having grown back as an aspen stand.

Set 60d spike	NW/side	8" Aspen	N18°E	15.97'
Set 60d spike	E/side	8" White Pine	S14°E	51.79'
Set 60d spike	S/side	5" Aspen	S76°W	15.85'
Set 60d spike	W/side	3" White Pine	N31°W	26.40'

All of the above new bearing trees are marked with upper and lower face blazes and scribed "NBT".