

MICHIGAN  
DEPARTMENT OF CONSERVATION  
FORESTRY DIVISION

# LAND CORNER RECORD

T. 50 N.R. 34w

Baraga COUNTY

DESCRIPTION OF CORNER Section Corner common to Sections 21-22-27-28

CORNER MONUMENT 1" Pipe with 4" Aluminum Cap.


DATE MONUMENT PLACED AND WITNESSED 6-1-61

WITNESSES TO CORNER..... 9" Y. Birch (S28 NBT) S54°W 08½ links

9" Hard Maple (S22 NBT) N14°E 15 links

6" Hard Maple (S27 NBT) S45°E 43½ links

AND

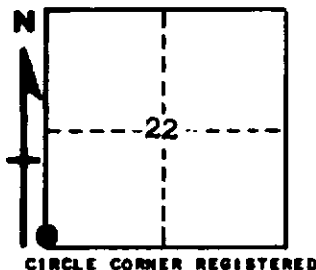

**DESCRIPTION IN DETAIL AS TO HOW CORNER WAS LOCATED AND IDENTIFIED OR RESTORED.**

This corner was replaced from one Hemlock B.T. a stump badly rotted with small piece of overgrowth on bottom blaze and Notch, bearing N64°E 12 links. Found definite wood stake about 1 foot deep in soil at corner. Found several blazes on trees facing Corner. No evidence of other Hemlock B.T.

**SURVEYOR'S SEAL**

SIGNED Billy D. Buckler DATE December 28, 1961  
REGISTERED LAND SURVEYOR  
Billy D. Buckler