LAND CORNER RECORDATION CERTIFICATE

Filing Requirement of Act 74, Mich. P.A. 1970 as Amended

For corners in

Baraga (County) Located In: Corner Code #

1. Public Land Survey		T		R		
		T		R		
		T		R		
2. Property Controlling in Section	S 30	T	50N	R	34W	1
	S 20	T	50N	R	34W	7
	S	T		R		
3. Miscellaneous Property in Sec.	S	T		R		
	S	T		R		

4. Lot No. _____, Recorded Plat _____

5. Private Claims

Register of Deeds Stamp & File Number

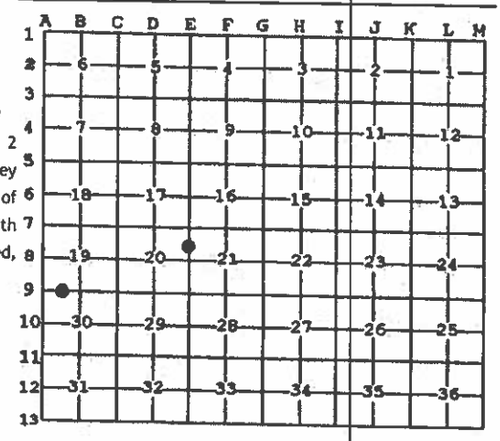

I, Stephan J. Szyszkoski, in a field survey on 1 05/20/13 7 05/22/13 do hereby state that under requirements of P.A. 74, Michigan P.A. of 1970, the corner points mentioned in lines 1 and 2 above were in conformance with regulations and rules therefore as required in the current manual of survey instructions of the United States Department of the Interior, Bureau of Land Management or by a decree of a Court of Law and /or that the corner points mentioned in lines 3, 4 and 5 above were in conformance with the rules of the Michigan Board of Land Surveyors or by a Decree of a Court of Law; established, re-established, monumented, recovered, found as expressed below:

NOTE: Not more than 2 corners, all in the same town and range, may be recorded on this certificate.

A. Description of original monument and accessories and/or subsequent restoration:

(1-Sec. 30) West 1/16 corner between Sections 19 and 30. Not previously monumented.

(7-Sec. 20) North 1/16 corner between Sections 20 and 21. Not previously monumented.

B. Description of corner evidence found and/or method applied in restoring or reestablishing corner:

(1-Sec. 30) Established the position for the corner on the Section line between Quarter corner 1318.59' east (20.00 ch. GLO) and Section corner 1087.85' west (16.50 ch. GLO), being proportionate to the original record.

(7-Sec. 20) Established the position for the corner midway and on the Section line between Quarter corner 1315.86' south and Section corner 1315.86' north.

C. Description of monument for corner and accessories established to perpetuate locating the position of the corner:

(1) Set 1"IDx32" I.pipe with 4" alum. MDNR cap.
Set measuring nail with MDNR tag in the side of:
5" W.Birch N21°W 18.25' mrkd "1/16S BT"
7" Maple N56°E 43.75' do
8" Hemlock S04°W 10.5' do
6" Maple S51°W 29.25' do
Set sq'd cedar post adjacent.
E= 7876843.665 N= 215188.616

(7) Set 1"IDx32" I.pipe with 4" alum. MDNR cap.
Set measuring nail with MDNR tag in the side of:
7" W.Pine N70°E 81.1' mrkd "1/16S BT"
5" W.Birch S13°W 71.1' do
6" Poplar S82°W 43.9' do
6" Hemlock N62°W 93.2' do
Set sq'd cedar post adjacent.
E= 7879685.174 N= 216335.188

Bearings are magnetic. Coordinates are MCS83 in meters (NAD83(2011) Datum)
Coord. Ref.=NGS PID DI1837: N= 221257.624 m. E= 7884435.168 m.

Signed by Stephan J. Szyszkoski Date 07/02/2013

Surveyor's Michigan License No. 33986

For the Michigan Department of Natural Resources, Forest Resources Division

STATE OF MICHIGAN STEPHAN J. SZYSZKOSKI LAND SURVEYOR No. 33986 LICENSED LAND SURVEYOR

FORM APPROVED BY MICHIGAN STATE BOARD OF PROFESSIONAL SURVEYORS JAN. 28, 1971
Revised May 1, 1975
Revised Jan., 1983
Revised Oct., 1995