

SURVEY & REMONUMENTATION

AUG 05 1994

COMMISSION

LAND CORNER RECORDATION CERTIFICATE
Filing Requirement of Act 74, Mich. P.A. 1970

For corners in

| | | |
|------------------------------------|-------------------------|---------------|
| <u>Baraga</u> (County) | Located In: | Corner Code # |
| 1. Public Land Survey | T 50N R 34W | C-1 |
| | T _____ R _____ | _____ |
| | T _____ R _____ | _____ |
| | T _____ R _____ | _____ |
| 2. Property Controlling in Section | S _____ T _____ R _____ | _____ |
| | S _____ T _____ R _____ | _____ |
| 3. Miscellaneous Property in Sec. | S _____ T _____ R _____ | _____ |
| | S _____ T _____ R _____ | _____ |

RECEIVED FOR RECORD THIS 2ND DAY OF AUGUST, A.D. 1994 AT 9:00 A.M. ALL RECORDED IN LIBER 4 OF LAND CORNER RECORDATION ON PAGE 501.

Helda J. Robillard

BARAGA COUNTY REGISTER OF DEEDS

Register of Deeds Stamp & File Number

4. Lot No. _____, Recorded Plat _____
 5. Private Claims _____

| | | | | | | | | | | | | |
|----|----|----|----|----|----|----|---|---|---|---|---|---|
| A | B | C | D | E | F | G | H | I | J | K | L | M |
| 2 | 6 | 5 | 4 | 3 | 2 | 1 | | | | | | |
| 3 | | | | | | | | | | | | |
| 4 | 7 | 8 | 9 | 10 | 11 | 12 | | | | | | |
| 5 | | | | | | | | | | | | |
| 6 | 18 | 17 | 16 | 15 | 14 | 13 | | | | | | |
| 7 | | | | | | | | | | | | |
| 8 | 19 | 20 | 21 | 22 | 23 | 24 | | | | | | |
| 9 | | | | | | | | | | | | |
| 10 | 30 | 29 | 28 | 27 | 26 | 25 | | | | | | |
| 11 | | | | | | | | | | | | |
| 12 | 31 | 32 | 33 | 34 | 35 | 36 | | | | | | |
| 13 | | | | | | | | | | | | |

I, Dennis R. Destrampe, in a field survey on December 17, 1993, do hereby certify that under requirements of P.A. 74, Michigan P.A. of 1970, the corner points mentioned in lines 1 and 2 above were in conformance with regulations and rules therefore as required in the current manual of survey instructions of the United States Department of the Interior, Bureau of Land Management or by a decree of a Court of Law and/or that the corner points mentioned in lines 3, 4 and 5 above were in conformance with the rules of the Michigan Board of Land Surveyors or by a Decree of a Court of Law; established, re-established, monumented, re-monumented, recovered, found as expressed below:


NOTE: Not more than 4 corners, all in the same town and range, may be recorded on this certificate.

A. Description of original monument and accessories and/or subsequent restoration:

| | |
|--------------------|---|
| Tamarack Post | Original corner not found. No record found of subsequent restoration. |
| Tamarack 8 S65W 28 | |
| Do 8 S40E 59 | |

B. Description of corner evidence found and/or method applied in restoring or reestablishing corner:

No evidence found of original corner or subsequent restoration. Traverse was run from standard corner at the SW corner of Section 36, T51N, R34W to standard corner at the SW corner of Section 34, T51N, R34W; corner was set by single proportionate method.

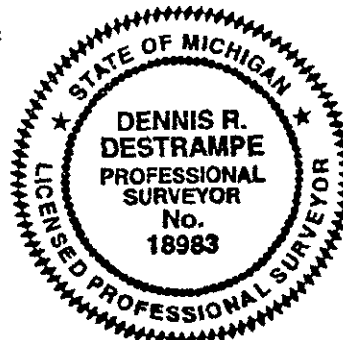

APPROVED LAND CORNER
 P.A. 345 OF 1990
 Baraga County

RD
12-1-93

C. Description of monument for corner and accessories established to perpetuate locating the position of the corner:

Set 1"X36" pipe with 2½" brass cap 0.5' above ground. Baraga Cty Remonumentation brass cap stamped:

Witnesses:

| | | |
|----------------|--------|-------------------------------|
| 5" Spruce S12E | 5.68' | (Nail & tag "UPEA 18983" set) |
| 5" Spruce N74E | 8.82' | (Nail & tag "UPEA 18983" set) |
| 7" Spruce S51E | 17.97' | (Nail & tag "UPEA 18983" set) |
| 6" Spruce N53W | 25.68' | (Nail & tag "UPEA 18983" set) |

1993
 S34
 S6 | S5
 T50N R34W
 G.C.

Signed by Dennis R. Destrampe Date June 7, 1994
 Surveyor's Michigan License No. 18983